


Give All Information Completely
Make Required Affidavit
Mail or Deliver Report to:
Conservation Division
State Corporation Commission
P. O. Box 17027
Wichita, Kansas 67217
NORTH

WELL PLUGGING RECORD

Graham County. Sec. 30 Twp. 9S Rge. 23W (E) (W)

Location as "NE/CNW/SW" or footage from lines NW SW SE
Lease Owner DONALD C. SLAWSON
Lease Name Cameron 'A' Well No. 1
Office Address 200 Douglas Building Wichita, Kansas 67202
Character of Well (completed as Oil, Gas or Dry Hole) Dry Hole
Date well completed November 12, 1981
Application for plugging filed November 12, 1981
Application for plugging approved November 12, 1981
Plugging commenced November 12, 1981
Plugging completed November 12, 1981
Reason for abandonment of well or producing formation Dry Hole

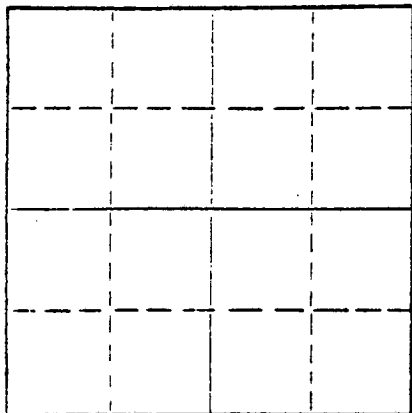

Locate well correctly on above Section Plat

If a producing well is abandoned, date of last production 19
Was permission obtained from the Conservation Division or its agents before plugging was commenced? Yes

Name of Conservation Agent who supervised plugging of this well Gilbert Balthazor
Producing formation Depth to top Bottom Total Depth of Well 4105 Feet
Show depth and thickness of all water, oil and gas formations.

OIL, GAS OR WATER RECORDS

CASING RECORD

FORMATION	CONTENT	FROM	TO	SIZE	PUT IN	PULLED OUT
		surface	287'	8 5/8"		

Describe in detail the manner in which the well was plugged, indicating where the mud fluid was placed and the method or methods used in introducing it into the hole. If cement or other plugs were used, state the character of same and depth placed, from feet to feet for each plug set.

1st plug @ 1200' w/70 sx
2nd plug @ 260' w/40 sx
Solid Bridge @ 40' w/10 sx
10 sx in Rat Hole

RECEIVED
STATE CORPORATION COMMISSION

JAN 19 1982

CONSERVATION DIVISION
Wichita, Kansas

1-19-82

(If additional description is necessary, use BACK of this sheet)

Name of Plugging Contractor Allied Cementing Co., Inc.
Address Box 31 Russell, Kansas 67665

STATE OF KANSAS, COUNTY OF SEDGWICK ss.
William R. Horigan (employee of owner) or (owner or operator) of the above-described


well, being first duly sworn on oath, says: That I have knowledge of the facts, statements, and matters herein contained and the log of the above-described well as filed and that the same are true and correct. So help me God.

(Signature) William R. Horigan
William R. Horigan, Operations Engineer

200 Douglas Bldg. (Address) Wichita, Kansas 67202

SUBSCRIBED AND SWORN to before me this 11th day of December, 1981

My commission expires 06/12/82

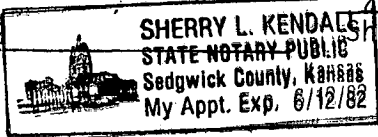

Sherry L. Kendall
Sherry L. Kendall Notary Public.