


Give All Information Completely
Make Required Affidavit
Mail or Deliver Report to:
Conservation Division
State Corporation Commission
212 No. Market
Wichita, Kansas

WELL PLUGGING RECORD

NORTH

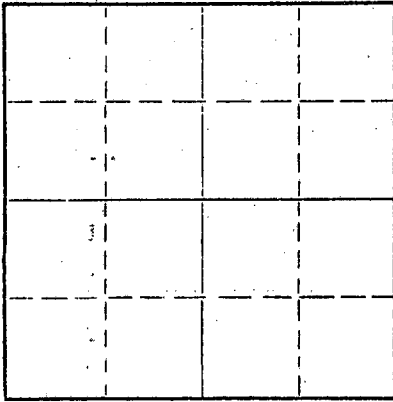

Locate well correctly on above
Section Plat

Graham County, Sec. 7 Twp. 9S Rge. (E) 24 (W)

Location as "NE/CNW/SW" or footage from lines NW NW SW
Lease Owner Empire Drilling Company
Lease Name Minium Well No. 1
Office Address 650 Fourth National Bldg.
Character of Well (completed as Oil, Gas or Dry Hole) Dry Hole
Date well completed 11-8 1968
Application for plugging filed 11-8 1968
Application for plugging approved 11-8 1968
Plugging commenced 11-8 1968
Plugging completed 11-8 1968
Reason for abandonment of well or producing formation Dry Hole

If a producing well is abandoned, date of last production 19
Was permission obtained from the Conservation Division or its agents before plugging was commenced? yes

Name of Conservation Agent who supervised plugging of this well W. L. Nichols
Producing formation Depth to top Bottom Total Depth of Well 4025 Feet
Show depth and thickness of all water, oil and gas formations.

OIL, GAS OR WATER RECORDS

CASING RECORD

FORMATION	CONTENT	FROM	TO	SIZE	PUT IN	PULLED OUT
				8 5/8"	180'	none

Describe in detail the manner in which the well was plugged, indicating where the mud fluid was placed and the method or methods used in introducing it into the hole. If cement or other plugs were used, state the character of same and depth placed, from feet to feet for each plug set.

Plugged with 100 sacks Posmix 6% gel @ 1210'
Plugged with 20 sacks Posmix 6% gel @ 155'
Plugged with 10 sacks Posmix 6% gel @ 40'

RECEIVED
STATE CORPORATION COMMISSION
NOV 14 1968
CONSERVATION DIVISION
Wichita, Kansas
11-14-1968

(If additional description is necessary, use BACK of this sheet)


Name of Plugging Contractor Leben Drilling, Inc.
Address Box 486, Great Bend, Kansas

STATE OF KANSAS, COUNTY OF BARTON, ss.
Leslie Kite (employee of owner) or (owner or operator) of the above-described well, being first duly sworn on oath, says: That I have knowledge of the facts, statements, and matters herein contained and the log of the above-described well as filed and that the same are true and correct. So help me God.

(Signature) Leslie Kite

SUBSCRIBED AND SWORN to before me this 12th day of November, 1968

My commission expires April 1, 1971
Ulanda Nichols Notary Public.

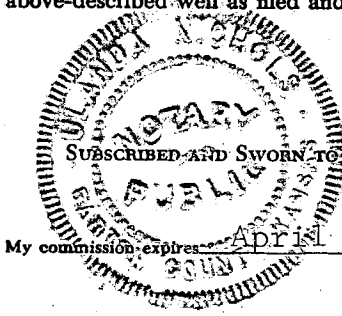

15-065-20180-00-00

DRILLER'S LOG

COMPANY
CONTRACTOR
FARM
LOCATION

COMMENCED
COMPLETED

Empire Drilling Company
LEBEN DRILLING, INC.
MINIUM #1
NW NW SW SECTION 7-9S-24W
GRAHAM COUNTY, KANSAS
11-2-68
11-8-68

0 130
130 160
160 180
180 1910
1910 2164
2164 2198
2198 2209
2209 3141
3141 3310
3310 3696
3696 3790
3790 4025
4025

Clay, Sand
Sand, Shale
Shale
Shale, Sand
Shale
Anhydrite
Shale
Shale, Lime
Lime, Shale
Lime
Lime, Shale
Lime
RTD - D. & A.

RECEIVED
STATE CORPORATION COMMISSION
NOV 14 1968
CONSERVATION DIVISION
Wichita, Kansas

8 5/8" 24# used surface casing set @ 180' cemented with 175 sacks
Common cement, 2% cc

I, Leslie Kite, do hereby certify that the above and foregoing is
a true and correct copy of the log of the Minium #1 Well, located
NW NW SW of Section 7, Township 9 South, Range 24 West, Graham
County, Kansas, as reflected by the records of Leben Drilling, Inc.

Leslie Kite

Leslie Kite

STATE OF KANSAS)
) SS
COUNTY OF BARTON)

Subscribed and sworn to and before me, a Notary Public, in
and for Barton County, Kansas, this 12th day of November, 1968.

Ulanda Nichols

Ulanda Nichols



Expires: