


15-065-21047-00-00

STATE OF KANSAS
STATE CORPORATION COMMISSION
CONSERVATION DIVISION
P. O. BOX 17027
WICHITA, KANSAS 67217

FORM CP-4

WELL PLUGGING RECORD

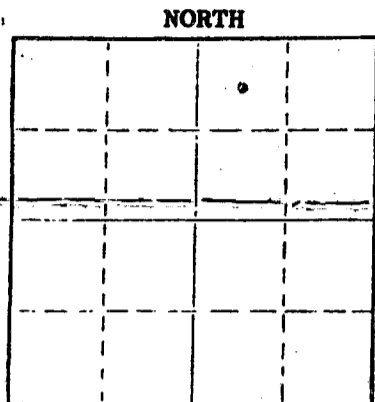

Locate well correctly on above Section Plat

Graham County, Sec. 12 Twp. 9 Rge. 24 (E) W (W)
Location as "NE/CNW/SE/SW" or footage from lines W/2 N W-NE
Lease Owner Ronald Nickelson
Lease Name Nickelson Well No. #1
Office Address Penokee
Character of Well (completed as Oil, Gas or Dry Hole) Oil
Date well completed 8-13 1978
Application for plugging filed 8-13 1978
Application for plugging approved 8-13 1978
Plugging commenced _____ 19____
Plugging completed 3:30 PM Aug. 13 1978
Reason for abandonment of well or producing formation D+A Dry + Abandoned

If a producing well is abandoned, date of last production _____ 19____
Was permission obtained from the Conservation Division or its agents before plugging was commenced? Yes

Name of Conservation Agent who supervised plugging of this well Gilbert Rathbun
Producing formation _____ Depth to top _____ Bottom _____ Total Depth of Well 4005 Feet
Show depth and thickness of all water, oil and gas formations.

OIL, GAS OR WATER RECORDS

CASING RECORD

FORMATION	CONTENT	FROM	TO	SIZE	PUT IN	PULLED OUT

RECEIVED
STATE CORPORATION COMMISSION
SEP 25 1978
09-25-1978

Describe in detail the manner in which the well was plugged, indicating where the mud fluid was placed and the method or methods used in introducing it into the hole. If cement or other plugs were used, state the character of same and depth placed from _____ feet to _____ feet for each plug set.

Pumped down Drillstem
70' 5x ccm 5 1/2 Poz mix 6 7/8 Gal @ 1050'
20' " " " " " " " 200'
Built Bridge To 40'
10' 5x ccm 5 1/2 Poz mix 6 7/8 Gal 40' to surface
2' " " " " " " in Rat hole
Cemented By Allied

Name of Plugging Contractor Lowbaco Drilling, Inc. Box 364, Hill City, Mo.
Address _____

STATE OF KANSAS COUNTY OF GRAHAM ss.

(employee of owner) or (owner or operator) of the above-described well, being first duly sworn on oath, says: That I have knowledge of the facts, statements, and matters herein contained and the log of the above-described well as filed and that the same are true and correct. So help me God.

(Signature) Ronald Nickelson
Penokee, Kansas
(Address)

SUBSCRIBED AND SWORN TO before me this 22nd day of September 1978

My commission expires 12-4-79
Avis Chipman
Notary Public.

