

15-065-00513-00-00


STATE OF KANSAS
STATE CORPORATION COMMISSION

WELL PLUGGING RECORD

Give All Information Completely
Make Required Affidavit
Mail or Deliver Report to:
Conservation Division
State Corporation Commission
211 No. Broadway
Wichita, Kansas

Graham County. Sec. 7 Twp. 9 Rge. 23 (W)

NORTH

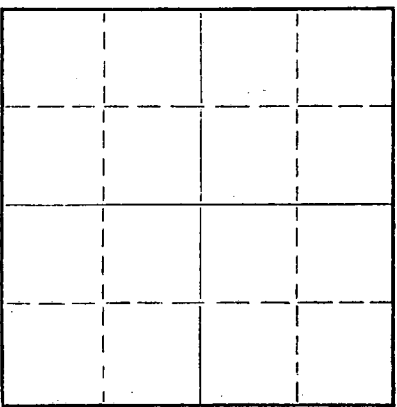

Locate well correctly on above
Section Plat

Location as "NE/CNW/SW" or footage from lines SE SE NW
Lease Owner Woodman & Iannitti Drilling Co.
Lease Name Davignon Well No. 1
Office Address Box 387, Hoisington, Kansas
Character of Well (completed as Oil, Gas or Dry Hole) Dry Hole
Date well completed 5-4 19 58
Application for plugging filed 5-4 19 58
Application for plugging approved 5-4 19 58
Plugging commenced 5-4 19 58
Plugging completed 5-4 19 58
Reason for abandonment of well or producing formation Dry

If a producing well is abandoned, date of last production 19
Was permission obtained from the Conservation Division or its agents before plugging was commenced? Yes.

Name of Conservation Agent who supervised plugging of this well A. D. Fabricius
Producing formation _____ Depth to top _____ Bottom _____ Total Depth of Well 3922 Feet
Show depth and thickness of all water, oil and gas formations.

OIL, GAS OR WATER RECORDS

CASING RECORD

FORMATION	CONTENT	FROM	TO	SIZE	PUT IN	PULLED OUT
				8 5/8"	142	

Describe in detail the manner in which the well was plugged, indicating where the mud fluid was placed and the method or methods used in introducing it into the hole. If cement or other plugs were used, state the character of same and depth placed, from _____ feet to _____ feet for each plug set.

Bottom plug 500' with 25 sacks cement. Middle plug 135' with 1/3 sack of hulls 15 sacks cement. Top plug 40' - 1/3 sack of hulls - 10 sacks cement.

RECEIVED
STATE CORPORATION COMMISSION

MAY 6 1958

CONSERVATION DIVISION
Wichita, Kansas

5-6-58

(If additional description is necessary, use BACK of this sheet)

Name of Plugging Contractor Woodman & Iannitti Drilling Co.
Address P. O. Box 387, Hoisington, Kansas

STATE OF KANSAS, COUNTY OF SEDGWICK, ss.
K. T. Woodman (employee of owner) or (owner or operator) of the above-described well, being first duly sworn on oath, says: That I have knowledge of the facts, statements, and matters herein contained and the log of the above-described well as filed and that the same are true and correct. So help me God.

(Signature) K. T. Woodman

714 Union National Bldg., Wichita 2, Kansas
(Address)

May 5, 19 58

Mildred E. Lick, Notary Public.



PLUGGING
FILE SEC 7 T 9 R 230
BOOK PAGE 98 LINE 29

DRILLING LOG

Company: Woodman & Iannitti Drilling Co. and Aurora Gasoline Co.

Lease: W. Davignon - SE 1/4 NW of 7-9-23, Graham County, Kansas

Contractor: Woodman & Iannitti Drilling Company
P. O. Box 387, Moisington, Kansas

Date Commenced: 4-24-58

Date Completed: 5-4-58

Total Depth: 3922'

Casing: 8 5/8" at 142 with 100 sacks cement

Figures Indicate the Bottom of the Formation

0-70	Shale & Sand	2570	lime
142	Shale	2680	lime & shale
1055	Shale	2950	lime & shale
1355	Shale & Sand	3030	lime
1560	Shale	3040	lime & shale
1775	Sand	3145	lime
1820	Red bed	3275	lime & shale
2015	Shale & red bed	3550	lime
2050	anhydrite	3922	lime
2055	Shale		
2155	Shale & red bed		
2220	Shale & Shells		
2240	Shale & lime		
3380	Shale		
2415	lime shale		

GEOLOGICAL TOPS

Elevation	2347 AB
anhydrite	
(driller)	2015 / 332
Hebner	3696 -1309
Toronto	3680 -1333
Lansing	3696 -1349
Base/AC	3920 -1573
Total Depth	3922 -1575

I certify the above to be a true and correct copy of the Driller's Log and Geological Tops to the best of my knowledge and belief.

WOODMAN & IANNITTI DRILLING CO.

By K. T. Woodman
K. T. Woodman

SI

MAY 6 1958

CONSERVATION DIVISION
Wichita, Kansas

PLUGGING
ONE SEC 7 T. 9 R. 23.4
LOG PAGE 90 LINE 29