


15-065-02261-00-00

WELL PLUGGING RECORD

Give All Information Completely
Make Required Affidavit
Mail or Deliver Report to:
Conservation Division
State Corporation Commission
211 No. Broadway
Wichita, Kansas

NORTH

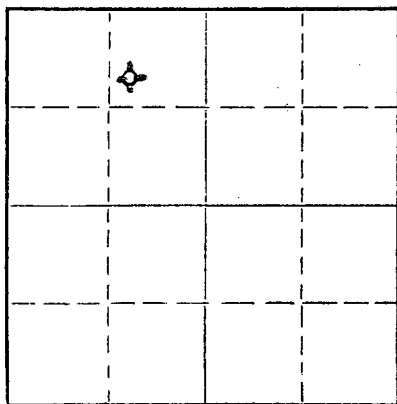

Locate well correctly on above
Section Plat

Graham County, Sec. 12 Twp. 9S Rge. 23W (E) (W)
Location as "NE/CNWxSWx" or footage from lines: SW NE NW
Lease Owner C-G Drilling Co. & Holly Oil Co.
Lease Name Mildrexter Well No. 1
Office Address 107 Rule Bldg., Wichita, Kansas
Character of Well (completed as Oil, Gas or Dry Hole) Dry Hole
Date well completed December 1 19 57
Application for plugging filed December 1 19 57
Application for plugging approved December 1 19 57
Plugging commenced December 1 19 57
Plugging completed December 1 19 57
Reason for abandonment of well or producing formation Too low structurally

If a producing well is abandoned, date of last production _____ 19 _____
Was permission obtained from the Conservation Division or its agents before plugging was commenced? Yes

Name of Conservation Agent who supervised plugging of this well Eldon Petty, Hays, Kansas
Producing formation _____ Depth to top _____ Bottom _____ Total Depth of Well 3869 Feet
Show depth and thickness of all water, oil and gas formations.

OIL, GAS OR WATER RECORDS

CASING RECORD

FORMATION	CONTENT	FROM	TO	SIZE	PUT IN	PULLED OUT
				8-5/8"	223.26'	none

Describe in detail the manner in which the well was plugged, indicating where the mud fluid was placed and the method or methods used in introducing it into the hole. If cement or other plugs were used, state the character of same and depth placed, from _____ feet to _____ feet for each plug set.

Filled hole with heavy mud to 700'. Set plug. Put in 20 sacks cement. Filled to 210'. Set plug. Put in 15 sacks cement. Filled with heavy mud up to 40'. Set plug. Filled to top with 1/2 sack hulls and 10 sacks cement.

RECEIVED
STATE CORPORATION COMMISSION
DEC 7 1957
CONSERVATION DIVISION
Wichita, Kansas

12-7-57

(If additional description is necessary, use BACK of this sheet)
Name of Plugging Contractor C-G Drilling Co.
Address 107 Rule Building, Wichita, Kansas

STATE OF KANSAS, COUNTY OF SEDGWICK, ss.
G. F. Galloway (employee of owner) or (owner or operator) of the above-described well, being first duly sworn on oath, says: That I have knowledge of the facts, statements, and matters herein contained and the log of the above-described well as filed and that the same are true and correct. So help me God.

(Signature) G. F. Galloway
G. F. Galloway 107 Rule Building
(Address)

SUBSCRIBED AND SWORN TO before me this 6th day of December, 1957

Vicky Jacobs
Vicky Jacobs Notary Public.



PLUGGING
FILE SEC 12 T 9 R 23W
BOOK PAGE 65 LINE 40

15-065-02261-00-00

CONTRACTOR'S WELL LOG

OPERATOR C-G Drilling Co. & Holly Oil Co. WELL NAME Mildrexter #1
LOCATION SW NE NW SEC. 12-9S-23W RIG NO. 2
COUNTY Graham STATE Kansas
COMMENCEMENT DATE November 22, 1957 COMPLETION DATE December 1, 1957

LOG OF WELL

Elevation 2332' rotary bushing.
All measurements taken from the top of rotary bushing.

FROM	TO	FORMATION	DEVIATION FROM VERTICAL	REMARKS:
0	223	Shale		
223	700	Shale		
700	1000	Shale-Shell		
1000	1220	Shale-Sand		
1220	1410	Shale-Sand		
1410	1730	Red Shale-Sand		
1730	1953	Red Shale-Sand		
1953	1965	Anhydrite		
1965	1989	Anhydrite		
1989	2185	Shale-Shell		
2185	2350	Shale-Shell		
2350	2500	Shale-Lime	0° - 2500	
2500	2635	Shale-Lime		
2635	2755	Shale-Lime	0° - 2750	
2755	2870	Shale-Lime		
2870	2994	Shale-Lime		
2994	3120	Shale-Lime	0° - 3000	
3120	3215	Shale-Lime		
3215	3285	Shale-Lime	0° - 3250	
3285	3423	Shale-Lime		
3423	3556	Shale-Lime		
3556	3624	Lime-Shale		
3624	3674	Lime		DST 3646-3685'
3674	3685	Lime		
3685	3726	Lime		
3726	3783	Lime		
3783	3797	Lime		DST 3783-3797'
3797	3838	Lime		
3838	3869	Lime		

CASING LEFT IN HOLE AFTER COMPLETION

Ran 223.26' (11 jts.) 8-5/8" OD Surface Casing.
STATE OF KANSAS }
COUNTY OF SEDGWICK } ss.

PLUGGING			
FILE	SEC	T. 9	R 23W
BOOK	PAGE	65	LINE 40

The undersigned hereby certifies that to the best of his knowledge and belief, the above facts are true and correct.

C-G DRILLING CO.

By G. F. Galloway
G. F. Galloway

SUBSCRIBED AND SWORN TO BEFORE ME THIS 6th day of December, 1957.

Vicky Jacobs
Vicky Jacobs, Notary Public

My commission expires: May 20, 1959

12-7-57