


Give All Information Completely
Make Required Affidavit
Mail or Deliver Report to:
Conservation Division
State Corporation Commission
212 No. Market
Wichita, Kansas

WELL PLUGGING RECORD

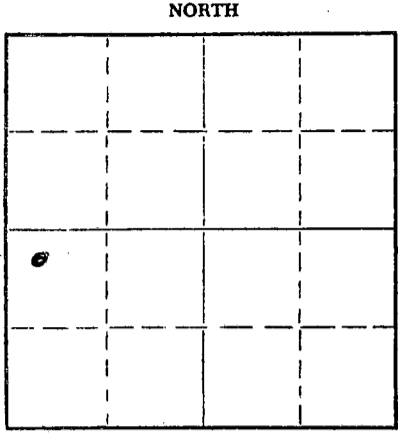

Locate well correctly on above Section Plat

Graham County. Sec. 11 Twp. 9s Rge. 23 (W)
Location as "NE/CNW/SW" or footage from lines NW-NW-SW
Lease Owner XXXXXXXX Associates Oil & Gas, Inc.
Lease Name Ninemire Well No. 1
Office Address Suite 501 120 South Market Wichita, Ks. 67202
Character of Well (completed as Oil, Gas or Dry Hole) Dry Hole
Date well completed Oct. 30 19 76
Application for plugging filed (oral) Oct. 30 19 76
Application for plugging approved Oct. 30 19 76
Plugging commenced Oct. 30 19 76
Plugging completed Oct. 30 19 76
Reason for abandonment of well or producing formation Dry hole

If a producing well is abandoned, date of last production _____ 19 ____
Was permission obtained from the Conservation Division or its agents before plugging was commenced? Yes

Name of Conservation Agent who supervised plugging of this well Gilbert Baltazor Palco, Ks.
Producing formation _____ Depth to top _____ Bottom _____ Total Depth of Well 3688 Feet
Show depth and thickness of all water, oil and gas formations.

OIL, GAS OR WATER RECORDS

CASING RECORD

FORMATION	CONTENT	FROM	TO	SIZE	PUT IN	PULLED OUT
Surface		0	209	8 5/8	X	

Describe in detail the manner in which the well was plugged, indicating where the mud fluid was placed and the method or methods used in introducing it into the hole. If cement or other plugs were used, state the character of same and depth placed, from _____ feet to _____ feet for each plug set.

Set first plug at 900 feet with 70 sacks cement 50-50 Poz 6% Gel.
Second plug at 200 feet with 20 sacks cement 50-50 Poz 6% Gel.
Bridge at 40 feet and plug to surface with 10 sacks cement 50-50 Poz. 6% Gel.

Plugged with pump truck by Allied Cementing Co., Inc. Russell, Ks.

DEC 06 1976
12-6-76
Conservation Division
Wichita, Kansas

(If additional description is necessary, use BACK of this sheet)

Name of Plugging Contractor Helberg Oil Co. (use of Allied Cementing)
Address Box 32 Morland, Kansas 67650

STATE OF Kansas, COUNTY OF Graham, ss.
Jerry M. Helberg (employee of owner) or (owner or operator) of the above-described well, being first duly sworn on oath, says: That I have knowledge of the facts, statements, and matters herein contained and the log of the above-described well as filed and that the same are true and correct. So help me God.

(Signature) Jerry M. Helberg
Box 32 Morland, Ks. 67650
(Address)

SUBSCRIBED AND SWORN TO before me this 3rd day of December, 19 76

Faye E. Minium
Notary Public.

My commission expires _____
FAYE E. MINIMUM
Graham County, Ks.
My Comm. Exp. Oct. 13, 1978

15-065-20874-00-00

DRILLERS LOG

NINEMIRE #1

CASING RECORD:

8 5/8" set at 209'

TOTAL DEPTH:

3688'

DESCRIPTION:

NW NW SW
SW 1/4 14-9-23 Graham County, Kansas

OPERATOR: Associates Oil & Gas, Inc.

CONTRACTOR: Helberg Oil Company

COMMENCED: October 22, 1976

COMPLETED: October 30, 1976

<u>FORMATION</u>	<u>FROM</u>	<u>TO</u>	<u>REMARKS</u>
Dirt & Shale	0	283	
Shale	283	981	
Shale	981	1347	
Shale & Sand	1347	1838	
Sahle	1838	1965	
Anhydrite	1965	1999	
Shale	1999	2085	
Sand & Shale	2085	2415	
Shale & Sand	2415	2505	
Shale	2505	2600	
Shale	2600	2835	
Sand & Shale	2835	2995	
Sand & Shale	2995	3040	
Lime & Shale	3040	3135	
Lime & Shale	3135	3235	
Shale & Lime	3235	3330	
Lime & Shale	3330	3415	
Lime & Shale	3415	3455	
Shale & Lime	3455	3489	
Shale & Lime	3489	3585	
Lime & Shale	3585	3670	
Lime & Shale	3670	3688	
T.D.	3688		

RECORDED
INDEXED
12-6-76
Graham County, Kansas

D & A

I certify that this is a true and correct copy of the above log to the best of my knowledge.

HELBERG OIL COMPANY

Jerry M. Helberg
Jerry M. Helberg

Subscribed and sworn to before me this 18th day of November, 1976.

STATE OF KANSAS
NOTARY PUBLIC
FAYE E. MINIUM
Graham County, Ks.
My Comm. Exp. Oct. 13, 1978

Faye E. Minium
Faye E. Minium, Notary Public