


15-163-01046-00-00

WELL PLUGGING RECORD

Give All Information Completely  
Make Required Affidavit  
Mail or Deliver Report to:  
Conservation Division  
State Corporation Commission  
212 North Market, Insurance Bldg.  
Wichita, Kansas

Rooks County, Sec. 2 Twp. 9S Rge. (E) 20(W)  
Location as "NE/CNW%SW%" or footage from lines C SE SW  
Lease Owner John O. Farmer, Inc.  
Lease Name Baldwin "C" Well No. 1  
Office Address 370 W. Wichita, Russell, Kansas  
Character of Well (completed as Oil, Gas or Dry Hole) Dry  
Date well completed 8/9 1962  
Application for plugging filed 8/9 1962  
Application for plugging approved 8/9 1962  
Plugging commenced 8/9 1962  
Plugging completed 8/9 1962  
Reason for abandonment of well or producing formation Dry

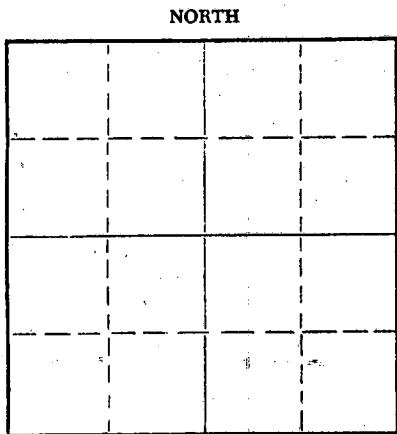

Locate well correctly on above Section Flat

If a producing well is abandoned, date of last production 19  
Was permission obtained from the Conservation Division or its agents before plugging was commenced? Yes

Name of Conservation Agent who supervised plugging of this well Eldon Petty  
Producing formation Depth to top Bottom Total Depth of Well 3660 Feet  
Show depth and thickness of all water, oil and gas formations.

OIL, GAS OR WATER RECORDS

CASING RECORD

FORMATION	CONTENT	FROM	TO	SIZE	PUT IN	PULLED OUT

Describe in detail the manner in which the well was plugged, indicating where the mud fluid was placed and the method or methods used in introducing it into the hole. If cement or other plugs were used, state the character of same and depth placed, from feet to feet for each plug set.

First Plug set at 540 with 20 sacks cement  
Second at 180 with 20 sacks cement  
Third at 40 with 10 sacks cement

RECEIVED  
STATE CORPORATION COMMISSION

AUG 15 1962

CONSERVATION DIVISION  
Wichita, Kansas

8-15-62

(If additional description is necessary, use BACK of this sheet)

Name of Plugging Contractor John O. Farmer, Inc.  
Address P. O. Box 352, Russell, Kansas


STATE OF Kansas, COUNTY OF Russell, ss.  
John O. Farmer (employee of owner) or (owner or operator) of the above-described

well, being first duly sworn on oath, says: That I have knowledge of the facts, statements, and matters herein contained and the log of the above-described well as filed and that the same are true and correct. So help me God.

(Signature) John O. Farmer President  
P. O. Box 352, Russell, Kansas (Address)

SUBSCRIBED AND SWORN TO before me this 14th day of August, 1962

My commission expires 5/18/64

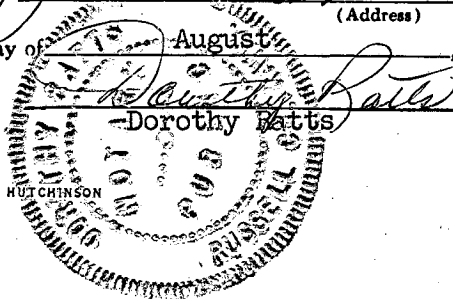

Notary Public.

