


15-163-26709-00-00

STATE OF KANSAS
STATE CORPORATION COMMISSION

WELL PLUGGING RECORD

Give All Information Completely
Make Required Affidavit
Mail or Deliver Report to
Conservation Division
State Corporation Comm.
245 North Water
Wichita, KS 67202

Rooks County, Sec. 4 Twp. 9 S Rge. 20 NW/W
Location as "NE/CNW $\frac{1}{4}$ SW $\frac{1}{4}$ " or footage from lines
NW NE SW
Lease Owner Kansas Oil Corporation
Lease Name Kellogg Well No. 1
Office Address 400 N. Woodlawn, Wichita, Kansas 67208
Character of Well (Completed as Oil, Gas or Dry Hole)
Dry Hole

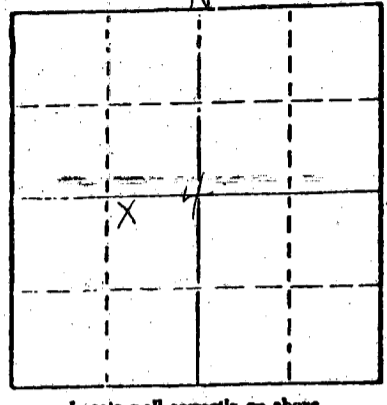

Locate well correctly on above
Section Plat

Date Well completed August 20, 1977
Application for plugging filed (verbally) August 20, 1977
Application for plugging approved (verbally) August 20, 1977
Plugging commenced August 20, 1977
Plugging completed August 20, 1977
Reason for abandonment of well or producing formation
No commercial quantity of oil or gas encountered
If a producing well is abandoned, date of last production
19

Was permission obtained from the Conservation Division or
its agents before plugging was commenced? Yes

Name of Conservation Agent who supervised plugging of this well Leo Massey
Producing formation _____ Depth to top _____ Bottom _____ Total Depth of Well 3790'
Show depth and thickness of all water, oil and gas formations.

OIL, GAS OR WATER RECORDS

CASING RECORD

FORMATION	CONTENT	FROM	TO	SIZE	PUT IN	PULLED OUT

Describe in detail the manner in which the well was plugged, indicating where the mud fluid
was placed and the method or methods used in introducing it into the hold. If cement or other
plugs were used, state the character of same and depth placed, from _____ feet to
_____ feet for each plug set.

RECEIVED
STATE CORPORATION COMMISSION

Set 1st plug at 720' with 70 sacks
2nd plug at 240' with 20 sacks
3rd plug at 40' with 10 sacks

AUG 20 1977

Plug was down at 8:30 p.m., August 20, 1977

CONSERVATION DIVISION
Wichita, Kansas

8-29-77


(If additional description is necessary, use BACK of this sheet)

Name of Plugging Contractor Abercrombie Drilling, Inc.

STATE OF Kansas COUNTY OF Sedgwick, ss.
Jack L. Partridge, Ass't. Secretary-Treasurer (employee of owner) or (owner or operator)
of the above-described well, being first duly sworn on oath, says: That I have knowledge of
the facts, statements, and matters herein contained and the log of the above-described well
as filed and that the same are true and correct. So help me God.

(Signature) Jack L. Partridge
801 Union Center, Wichita, Kansas 67202
(Address)

SUBSCRIBED AND SWORN TO before me this 26th day of AUGUST, 1977

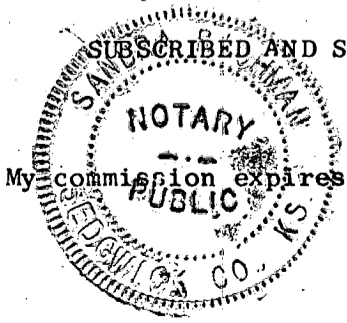

Sandra Richman
Sandra Richman Notary Public.

July 21, 1979

OPERATOR: Kansas Oil Corporation
 CONTRACTOR: Abercrombie Drilling, Inc.
 WELL NAME: Kellogg #1
 LOCATION: NW NE SW Section 4-9S-20W
 Rooks County, Kansas
 SPUD DATE: August 15, 1977
 COMPLETION DATE: August 20, 1977

0	230	Clay & sand
230	1245	Shale
1245	1435	Sand
1435	1735	Shale
1735	1779	Anhydrite
1779	2074	Shale
2074	2819	Shale & lime
2819	3370	Lime & shale
3370	3735	Lime
3735	3790	Lime & Conglomerate
	3790	Rotary Total Depth

Spud hole at 4:00 p.m., August 15, 1977. Drilled 260' of 12 1/4" hole, ran 6 joints of 8-5/8" surface casing, set at 259' K.B. Cemented with 190 sacks common cement, 3% CaCl, 2% gel. Plug was down at 8:15 p.m., August 15, 1977

T. D. 3790'. Set 1st plug at 720' with 70 sacks, 2nd plug at 240' with 20 sacks, 40' bridge with 10 sacks. Cemented with 50/50 posmix, 6% gel. Plug was down at 8:30 p.m., August 20, 1977. State Plugger - Leo Massey

SAMPLE TOPS:

Anhydrite 1736'
 B/Anhydrite 1779'


STATE OF KANSAS)
) ss
 COUNTY OF SEDGWICK)

Jack L. Partridge, Assistant Secretary-Treasurer of Abercrombie Drilling, Inc., does hereby state that the above and foregoing is a true and correct copy of the log of the Kellogg #1, NW NE SW Section 4-9S-20W, Rooks County, Kansas.

ABERCROMBIE DRILLING, INC.

By Jack L. Partridge
 Jack L. Partridge,
 Assistant Secretary-Treasurer

Subscribed and sworn to before me, a Notary Public, in and for the aforesaid county and state as of this 26th day of August, 1977.

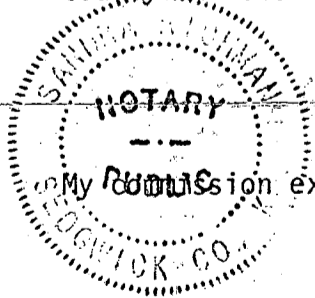

Sandra Richman
 Sandra Richman, Notary Public