


Give All Information Completely
Make Required Affidavit
Mail or Deliver Report to:
Conservation Division
State Corporation Commission
211 No. Broadway
Wichita, Kansas

WELL PLUGGING RECORD

Rooks County, Sec. 5 Twp. 9S Rge. (E) 20 (W)

Location as "NE/CNWxSWx" or footage from lines NE/4 NE/4 SW/4
Lease Owner Skelly Oil Company
Lease Name A. E. Arpin Well No. 1
Office Address P. O. Box 1650, Tulsa, Oklahoma
Character of Well (completed as Oil, Gas or Dry Hole) Oil
Date well completed February 8, 19 57
Application for plugging filed August 6, 19 65
Application for plugging approved September 27, 19 65
Plugging commenced September 18, 19 65
Plugging completed September 24, 19 65
Reason for abandonment of well or producing formation Depleted

If a producing well is abandoned, date of last production July 3, 19 65
Was permission obtained from the Conservation Division or its agents before plugging was commenced? Yes (verbally)

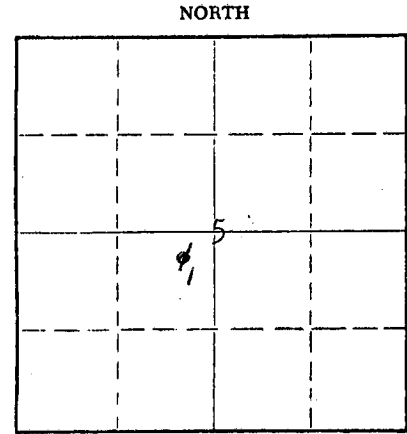

Locate well correctly on above Section Plat

Name of Conservation Agent who supervised plugging of this well Mr. W. L. Nichols
Producing formation Arbuckle Lime Depth to top 3652' Bottom _____ Total Depth of Well 3678' Feet
Show depth and thickness of all water, oil and gas formations. PB 3676'

OIL, GAS OR WATER RECORDS

CASING RECORD

FORMATION	CONTENT	FROM	TO	SIZE OD	PUT IN	PULLED OUT
Arbuckle Lime	Oil	3655'	3676'	8-5/8"	312'	None
				5-1/2"	3707'	2432'6"

Describe in detail the manner in which the well was plugged, indicating where the mud fluid was placed and the method or methods used in introducing it into the hole. If cement or other plugs were used, state the character of same and depth placed, from _____ feet to _____ feet for each plug set.

Sand	3676' to 3520'
4 sacks of cement	3520' to 3488'
Mud laden fluid	3488' to 475'
20 sacks of cement	475' to 415'
Mud laden fluid	415' to 295'
20 sacks of cement	295' to 235'
Mud laden fluid	235' to 40'
Rock bridge	40' to 30'
10 sacks of cement	30' to Base cellar
Surface soil	Cellar to Surface

RECEIVED
STATE CORPORATION COMMISSION

OCT 11 1965

CONSERVATION DIVISION
Wichita, Kansas

10-11-65

(If additional description is necessary, use BACK of this sheet)
Name of Plugging Contractor Southwest Casing Pulling Co., Inc.
Address P. O. Box 364, Great Bend, Kansas

STATE OF Nebraska, COUNTY OF Red Willow, ss.
C. F. Bass (employee of owner) or (owner or operator) of the above-described well, being first duly sworn on oath, says: That I have knowledge of the facts, statements, and matters herein contained and the log of the above-described well as filed and that the same are true and correct. So help me God.

(Signature) C. F. Bass
P. O. Box 364, McCook, Nebr. 69001
(Address)

SUBSCRIBED AND SWORN TO before me this 8th day of October, 19 65
C. E. Lindsey Notary Public.

My commission expires June 13, 1969