

15-163-21224-00-00


STATE OF KANSAS
STATE CORPORATION COMMISSION

WELL PLUGGING RECORD

Give All Information Completely
Make Required Affidavit
Mail or Deliver Report to
Conservation Division
State Corporation Comm.
245 North Water
Wichita, KS 67202

Rooks County, Sec. 12 Twp. 9 Rge. 20W E/W
Location as "NE/CNW/SW" or footage from lines

C NE NE SW
Lease Owner Sid Tomlinson
Lease Name Duane Lambert Well No. #1
Office Address Box 594 Twin Falls, Idaho 83301
Character of Well (Completed as Oil, Gas or Dry Hole)

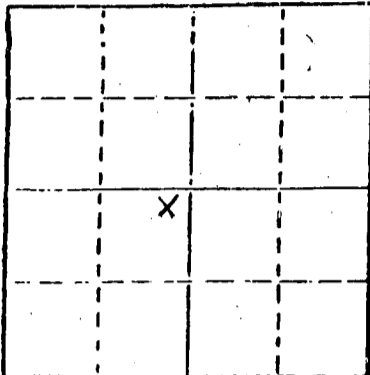

Locate well correctly on above
Section Plat

Dry Hole
Date Well completed 4-5-81 19
Application for plugging filed 4-4 19 81
Application for plugging approved 4-4 19 81
Plugging commenced 4-4 4:00 PM 19 81
Plugging completed 4-5 6:00AM 19 81
Reason for abandonment of well or producing formation

Dry Hole
If a producing well is abandoned, date of last production 19

Was permission obtained from the Conservation Division or its agents before plugging was commenced? yes

Name of Conservation Agent who supervised plugging of this well Gilbert Balthazor
Producing formation Depth to top Bottom Total Depth of Well 3620'
Show depth and thickness of all water, oil and gas formations.

OIL, GAS OR WATER RECORDS

8 5/8 259'

CASING RECORD

FORMATION	CONTENT	FROM	TO	SIZE	PUT IN'	PULLED OUT

Describe in detail the manner in which the well was plugged, indicating where the mud fluid was placed and the method or methods used in introducing it into the hold. If cement or other plugs were used, state the character of same and depth placed, from feet to feet for each plug set.

- Filled hole to 750' with heavy mud and mixed 60 sacks of cement and pumped in hole thru drill pipe.
- Filled hole to 280' with heavy mud mixed 30 sacks of cement and pumped in hole thru drill pipe.
- Filled hole to 40' built bridge and pushed down plug mixed 10 sacks of cement and filled hole to bottom of cellar.
- Mixed 5 sacks and poured in rat hole.

RECEIVED
STATE CORPORATION COMMISSION

All cement used was 50-50 Poz Mix 6% Cel.


(If additional description is necessary, use BACK of this sheet)

Name of Plugging Contractor Revlin Drlg., Inc.

MAY 11 1981
05 11 1981
CONSERVATION DIVISION

STATE OF Kansas COUNTY OF Russell, ss.
Stanley C. Lingreen (employee of owner) or (owner or operator)

of the above-described well, being first duly sworn on oath, says: That I have knowledge of the facts, statements, and matters herein contained and the log of the above-described well as filed and that the same are true and correct. So help me God.

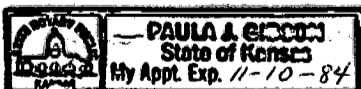

(Signature)

Stanley C. Lingreen
Box 293 Russell, Kansas 67665
(Address)

SUBSCRIBED AND SWORN TO before me this 20th day of April, 1981

Paula J. Gibson
Notary Public.

My commission expires November 10, 1984