


WELL PLUGGING RECORD

Give All Information Completely
Make Required Affidavit
Mail or Deliver Report to:
Conservation Division
State Corporation Commission
212 North Market, Insurance Bldg.
Wichita, Kansas

Rooks County, Sec. 14 Twp. 9S Rge. (E) 20W(W)

NORTH

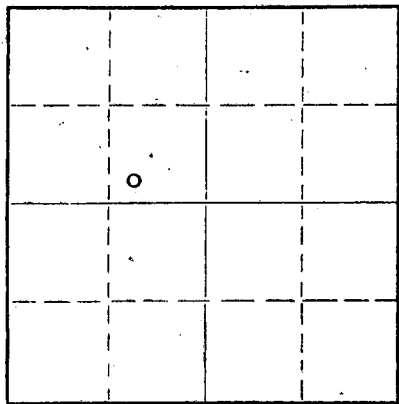

Locate well correctly on above Section Plat

Location as "NE/CNWxSWx" or footage from lines SW SE NW
Lease Owner Raymond Oil Company, Inc.
Lease Name MARY KERN Well No. 1
Office Address 410 Fourth National Bank Bldg., Wichita 2, Kansas
Character of Well (completed as Oil, Gas or Dry Hole) Dry Hole
Date well completed December 31 19 60
Application for plugging filed January 3 19 60
Application for plugging approved January 4 19 60
Plugging commenced December 31 19 60
Plugging completed December 31 19 60
Reason for abandonment of well or producing formation _____

If a producing well is abandoned, date of last production _____ 19 _____
Was permission obtained from the Conservation Division or its agents before plugging was commenced? Yes

Name of Conservation Agent who supervised plugging of this well Eldon Petty, Hays, Kansas
Producing formation _____ Depth to top _____ Bottom _____ Total Depth of Well 3752' Feet
Show depth and thickness of all water, oil and gas formations.

OIL, GAS OR WATER RECORDS

CASING RECORD

FORMATION	CONTENT	FROM	TO	SIZE	PUT IN	PULLED OUT

Describe in detail the manner in which the well was plugged, indicating where the mud fluid was placed and the method or methods used in introducing it into the hole. If cement or other plugs were used, state the character of same and depth placed, from _____ feet to _____ feet for each plug set.


Plug set at 580 feet with 20 sacks cement through drill pipe. Filled hole to 180 feet with 44 Vis. RM. Set plug with 20 sacks cement through drill pipe. Filled hole to 50 feet with R.M. Set plug with 10 sacks cement.
Hole plugged at 9 P.M., December 31, 1960

RECEIVED
STATE CORPORATION COMMISSION
FEB 27 1961
02-23-1961
CONSERVATION DIVISION
Wichita, Kansas

(If additional description is necessary, use BACK of this sheet)
Name of Plugging Contractor Raymond Oil Company, Inc. - Rig #2
Address 410 Fourth National Bank Bldg., Wichita 2, Kansas

STATE OF KANSAS, COUNTY OF SEDGWICK, ss.
Rick P. Clinton (employee of owner) or (owner/operator) of the above-described well, being first duly sworn on oath, says: That I have knowledge of the facts, statements, and matters herein contained and the log of the above-described well as filed and that the same are true and correct. So help me, God.
(Signature) Rick P. Clinton
Wichita, Kansas (Address)

SUBSCRIBED AND SWORN TO before me this 4th day of January, 19 61
My commission expires May 13, 1962
Marie Ellen Sampson Notary Public.

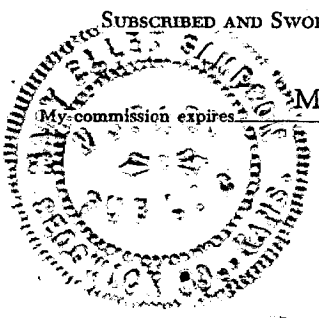

15-163-00821-00-00

Raymond Oil Company, Inc. #1 MARY KERN
SW SE NW, 14-9S-20W
Rooks County, Kansas

Elevation: 2154 KB
2151 DF
2149 GL

Contractor: Raymond Oil Co., Inc. -Rig #2
Commenced: December 18, 1960
Completed: December 31, 1960 (rotary)

Casing Record:
8-5/8" @ 189' w/170 sacks, 2% CC

Figures Indicate Bottom of Formation

Formation	Depth
Surface hole	189
Lime & shale	600
Shale & shells	1000
Shale with lime streaks	1050
Shale & shells	1600
Anhydrite	1635
Lime	1700
Shale & salt	1910
Lime	1940
Shale & shells	1945
Lime with shale	2910
Shale & lime shells	2980
Lime & shale	3085
Lime with shale streaks	3137
Shale	3146
Lime	3168
Lime with shale	3352
Shale	3356
Lime	3365
Shale	3375
Lime	3390
Shale	3393
Lime	3614
Shale	3646
Chert with shale	3679
Dolomite	3752

RECEIVED
STATE CORPORATION COMMISSION
FEB 23 1961
CONSERVATION DIVISION
Wichita, Kansas

Tops:

Anhydrite (driller's)	1600
Topeka	3146
Heebner	3352
Toronto	3375
Lansing	3393
Base Kansas City	3614
Conglomerate	3646
Arbuckle	3679
Rotary Total Depth	3752
D & A	

STATE OF KANSAS)
) SS
COUNTY OF SEDGWICK)

I hereby certify that the above is true and correct to the best of my knowledge.

Rick P. Clinton
Rick P. Clinton

Subscribed and sworn to before me this 5th day of January, 1961.

Mary Ellen Sampson
Notary Public

My Commission Expires: May 13, 1962