


STATE OF KANSAS  
STATE CORPORATION COMMISSION

15-163-00441-00-00

WELL PLUGGING RECORD

Give All Information Completely  
Make Required Affidavit  
Mail or Deliver Report to:  
Conservation Division  
State Corporation Commission  
800 Bittling Building  
Wichita, Kansas

NORTH

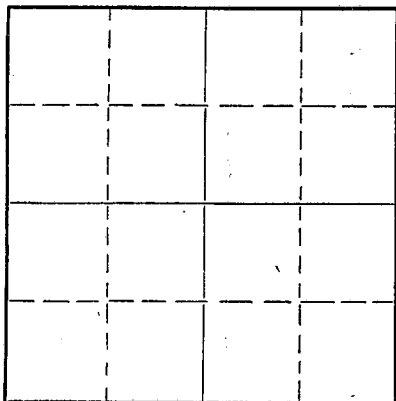

Locate well correctly on above  
Section Plat

Brooks County. Sec 16 Twp. 9 Rge. (E) 20 (W)  
Location as "NE/CNW $\frac{1}{4}$ SW $\frac{1}{4}$ " or footage from lines NE NE SE  
Lease Owner LOHMANN JOHNSON DRIG. CO. INC.  
Lease Name J. M. TRIBLE Well No. L  
Office Address 320 Indiana Bank Building, Evansville, Indiana  
Character of Well (completed as Oil, Gas or Dry Hole) dry hole  
Date well completed August 1, 1952  
Application for plugging filed August 8 1952  
Application for plugging approved 19  
Plugging commenced Aug. 1 1952  
Plugging completed Aug. 1 1952  
Reason for abandonment of well or producing formation dry hole

If a producing well is abandoned, date of last production 19  
Was permission obtained from the Conservation Division or its agents before plugging was commenced? yes

Name of Conservation Agent who supervised plugging of this well Eldon Petty  
Producing formation Depth to top Bottom Total Depth of Well 3830 Feet  
Show depth and thickness of all water, oil and gas formations.

OIL, GAS OR WATER RECORDS

CASING RECORD

Formation	Content	From	To	Size	Put In	Pulled Out
				8 5/8"	214'	none

Describe in detail the manner in which the well was plugged, indicating where the mud fluid was placed and the method or methods used in introducing it into the hole. If cement or other plugs were used, state the character of same and depth placed, from feet to feet for each plug set.

Filled hole to 200 ft. with drilling mud, set bridge and cemented with 15 sacks, filled with mud to 40 ft.; set bridge and cemented with 10 sacks of cement.

RECEIVED  
STATE CORPORATION COMMISSION  
AUG 28 1952  
CONSERVATION DIVISION  
Wichita, Kansas

(If additional description is necessary, use BACK of this sheet)


Correspondence regarding this well should be addressed to LOHMANN JOHNSON DRIG. CO. INC  
Address 320 Indiana Bank Building, Evansville, Indiana

STATE OF Indiana, COUNTY OF Vanderburgh, ss.  
J. W. Kendall (employee of owner) or (owner or operator) of the above-described well,  
being first duly sworn on oath, says: That I have knowledge of the facts, statements, and matters herein contained and the log of the above-described well as filed and that the same are true and correct. So help me God.

(Signature) *James W. Kendall*  
320 Indiana Bank Building, Evansville, Indiana (Address)

Subscribed and sworn to before me this 18 day of August, 1952.

*Art W. Rump*  
Notary Public.

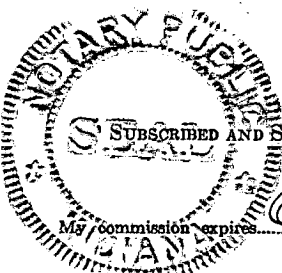

23-9278-5 4-50-10M  
**PLUGGING**  
FILE SEC 16 T 9 R 200  
BOOK PAGE 35 LINE 25

15-143 - 00441 - 00 - 00

J. M. TRIBLE #1

Well Record

Location: Rooks County, Kansas  
Operator: Lohmann-Johnson Drilling Co., Inc.  
Contractor: Lohmann-Johnson Drilling Co., Inc.  
Casing Record: Set 213.84' 8 5/8 Surface pipe with 125 sacks.  
Commenced: July 23, 1952  
Completed: July 31, 1952

LOG

FROM	TO	FORMATION
0	225	Shale
225	809	Shale
809	875	Sand
875	1067	Shale & shells
1067	1380	Shale
1380	1637	Shale & shells
1637	1684	Red Bed
1684	1720	Anhydrite
1720	2107	Shale & lime
2107	2285	Broken lime
2285	2435	Shale & shells
2435	2600	Shale & lime
2600	2725	Shale & lime
2725	2865	Shale & lime
2865	3020	Shale & lime
3020	3127	Shale & lime
3127	3246	Shale & lime
3246	3366	Lime & shale
3366	3425	Lime & shale
3425	3465	Lime
3465	3549	Lime
3549	3584	Lime & shale
3584	3632	Shale & lime
3632	3688	Conglomerate
3688	3740	Conglomerate
3740	3804	Shale & chert
3804	3830	Lime
3830		Lime & shale
		Total Depth

RECEIVED  
STATE CORPORATION  
AUG 2 1952  
CONSERVATION DIVISION

I, the undersigned, being first duly sworn upon oath, state that this well record is true, correct and complete according to the records of this office and to the best of my knowledge and belief.

D. Given  
D. Given

Subscribed and sworn to before me this 16th day of August,

1952.  
My Commission Expires:  
October 14, 1952.

Art M. Trumpf  
Notary Public



PLUGGING  
FILE SEC 169 R200  
BOOK PAGE 35 LINE 25