


15-163-03244-00-00

WELL PLUGGING RECORD

Give All Information Completely  
Make Required Affidavit  
Mail or Deliver Report to:  
Conservation Division  
State Corporation Commission  
800 Bitting Building  
Wichita, Kansas

NORTH

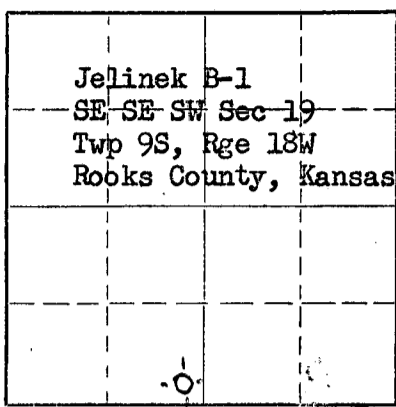

Locate well correctly on above Section Plat

Rooks County. Sec. 19 Twp. 9S Rge. 18 ~~XE~~ W (W)  
Location as "NE/CNW&SW" or footage from lines SE SE SW  
Lease Owner Heathman & Company Wichita Kansas  
Lease Name Jelinek B-1 Well No. \_\_\_\_\_  
Office Address 254 N. Washington Wichita, Kansas.  
Character of Well (completed as Oil, Gas or Dry Hole) Dry Hole  
Date well completed 3-24 19 53  
Application for plugging filed 3-23 19 53  
Application for plugging approved 3-23 19 53  
Plugging commenced 3-23 10:00 P. M. 19 53  
Plugging completed 3-24 2:30 A. M. 19 53  
Reason for abandonment of well or producing formation Dry Hole

If a producing well is abandoned, date of last production \_\_\_\_\_ 19 \_\_\_\_  
Was permission obtained from the Conservation Division or its agents before plugging was commenced? Yes Verbal

Name of Conservation Agent who supervised plugging of this well Eldon Petty  
Producing formation \_\_\_\_\_ Depth to top \_\_\_\_\_ Bottom \_\_\_\_\_ Total Depth of Well 3608 Feet  
Show depth and thickness of all water, oil and gas formations.

OIL, GAS OR WATER RECORDS

CASING RECORD

FORMATION	CONTENT	FROM	TO	SIZE	PUT IN	PULLED OUT
Sand & Shale		0	60			
Blue Shale & Shells		60	143	8 5/8	143'8	None
Anhydrite		1540	1577			
Lime & Shale		2080	3350			
Lime		3350	3608			
T. Depth		3608				

Describe in detail the manner in which the well was plugged, indicating where the mud fluid was placed and the method or methods used in introducing it into the hole. If cement or other plugs were used, state the character of same and depth placed, from \_\_\_\_\_ feet to \_\_\_\_\_ feet for each plug set.

Stirred pits well filled hole with heavy mud to 140' set bottom plug ran 1/2 sack hulls and 15 sacks of cement. Set top plug at 40' Ran 1/2 sack hulls and 10 sacks of cement filling to the bottom of the cellar.

RECEIVED  
STATE CORPORATION COMMISSION  
MAR 31 1953  
CONSERVATION DIVISION  
Wichita, K.

Name of Plugging Contractor Strain Drilling Company 3-31-53  
Address Box 188 Hays, Kansas.

STATE OF KANSAS, COUNTY OF ELLIS, ss.  
T. C. Strain (employee of owner) or (owner or operator) of the above-described well, being first duly sworn on oath, says: That I have knowledge of the facts, statements, and matters herein contained and the log of the above-described well as filed and that the same are true and correct. So help me, God. T. C. Strain

(Signature) T. C. Strain  
Box 188 Hays, Kansas. (Address)

SUBSCRIBED AND SWORN TO before me this 26th day of March, 19 53

My commission expires March 26, 1956

Mildred Schneider Notary Public.

PLUGGING  
FILE SEC 19 T 9 R 18W  
BOOK PAGE 88 LINE 11

15-163-03244-00-00

WELL LOG

COMPANY: Heathman & Company

SE SE SW Sec 19  
Twp 9S, Rge 18W  
Rooks County, Kansas.

LEASE: Jelinek B-1

ELEVATION: 2162 R. B.

NOTE: All meas Rotary Bushings.

0	60 Sand & Shale
60	130 Blue Shale & Shells
130	143 Blue Shale & Shells
143	490 Blue Shale
490	830 Shale & Shells
830	980 Sand & Shale
980	1015 Shale
1015	1030 Shale & Hard Sand
1030	1260 Sand
1260	1534 Redbed & Shale
1534	1540 Anhydrite
1540	1577 Anhydrite
1577	1760 Shale & Shells
1760	1960 Shale & Shells
1960	2080 Lime & Shale
2080	2185 Lime & Shale
2185	2285 Lime & Shale
2285	2215 Lime
2315	2325 Lime & Shells
2325	2420 Lime
2420	2475 Lime
2475	2520 Shale & Lime
2520	2665 Lime & Shale
2665	2755 Lime & Shale
2755	2813 Lime & Shale
2813	2980 Shale & Lime
2980	3155 Shale & Lime
3155	3230 Shale & Lime
3230	3275 Shale & Lime
3275	3350 Lime

3350	3385 Lime
3385	3424 Lime
3424	3470 Lime
3470	3515 Lime
3515	3560 Lime
3560	3608 T. D.
3608	( Total Depth )

COMMENCED: 3-13-53  
COMPLETED: 3-24-53

CASING RECORD:

8 5/8 Surface Casing set at 143' W/100 sacks of cement by Globe Cementing Co.

No Electric Logs Run

Geologist Bob Armstrong

TOPS:

Anhydrite	1540 (+622)	Lansing K. C.	3352 (-1190)
Topeka	3105 (-943)	Base K. C.	3564 (-1402)
Heebner	3311 (-1149)	Total Depth	3608 (-1446)

STATE OF KANSAS) SS  
COUNTY OF ELLIS

I hereby affirm that the above and foregoing is a true and correct copy of the Log of the Jelinek B-1, located SE SE SW Sec. 19, Twp 9S, Rge 18W Rooks County, Kansas.

CONTRACTOR Strain Drilling Company

BY: J.C. Strain  
MAR 31 1953

SERVATION DIVISION  
Wichita, Kansas  
March 1953

Subscribed and sworn to before me this 26th day of March 1956  
My Commission expires March 26, 1956

Mildred Schneider  
Notary Public.

**PLUGGING**  
FILE SEC. 19 T 9 R 18W  
BOOK PAGE 88 LINE 11