

15-163-04012-06-00

STATE OF KANSAS
STATE CORPORATION COMMISSION


Give All Information Completely
Make Required Affidavit
Mail or Deliver Report to:
Conservation Division
State Corporation Commission
800 Bitting Building
Wichita, Kansas

WELL PLUGGING RECORD

Rooks County. Sec. 19 Twp. 9S Rge. (E) 18 (W)

Location as "NE/CNW/SW" or footage from lines SE SE SE
Lease Owner Continental Oil Co.
Lease Name L.B. Gilbert Well No. 1
Office Address Box 161, Great Bend, Kansas
Character of Well (completed as Oil, Gas or Dry Hole) Oil
Date well completed 4-16- 19 53
Application for plugging filed 7-20- 19 55
Application for plugging approved 7-27- 19 55
Plugging commenced 7-29- 19 55
Plugging completed 8-1- 19 55
Reason for abandonment of well or producing formation Production depleted and other zone tested was non productive.
If a producing well is abandoned, date of last production 4-21- 19 55
Was permission obtained from the Conservation Division or its agents before plugging was commenced? Yes

NORTH

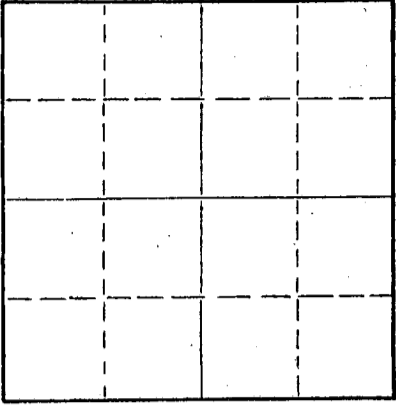

Locate well correctly on above Section Plat

Name of Conservation Agent who supervised plugging of this well Elden Petty
Producing formation Arbuckle Depth to top 3620 Bottom 3628 Total Depth of Well 3628 Feet
Show depth and thickness of all water, oil and gas formations. PB 3570'

OIL, GAS OR WATER RECORDS

CASING RECORD

FORMATION	CONTENT	FROM	TO	SIZE	PUT IN	PULLED OUT
Arbuckle	Oil&water	3620	3628	10 3/4	208' 11"	None
Lansing	water	3360	3376	5 1/2	3627' 1"	2581.79

Describe in detail the manner in which the well was plugged, indicating where the mud fluid was placed and the method or methods used in introducing it into the hole. If cement or other plugs were used, state the character of same and depth placed, from _____ feet to _____ feet for each plug set.

1 Sanded hole to 3345' and dumped 4 sacks cement. Filled hole to 3017'. Shot pipe off at 2570'. Pulled pipe and mudded hole to 200'. Set 10' rock bridge and run 20 sacks cement. Cement filled to 150'. Mudded hole to 35. Set 10' rock bridge and run 10 sacks to bottom of cellar.

RECEIVED
STATE CORPORATION COMMISSION
AUG 6 X 1955

(If additional description is necessary, use BACK of this form)
Name of Plugging Contractor West Supply Co. Conservation Division
Address Chase, Kansas Wichita, Kansas 8-6-55

STATE OF Kansas, COUNTY OF Barton, ss.
F.L. Dunn (employee of owner) or (owner or operator) of the above-described well, being first duly sworn on oath, says: That I have knowledge of the facts, statements, and matters herein contained and the log of the above-described well as filed and that the same are true and correct. So help me God.

ARC-MJJ
8-4-55
State RFD File
(Signature) F.L. Dunn
Box 161, Great Bend, Kansas
(Address)

SUBSCRIBED AND SWORN TO before me this 4 th day of August, 19 55

D. E. Jones
Notary Public.



PLUGGING
FILE SEC. 14 T. 9 R. 18 W
BOOK PAGE 137 LINE 34

15-163-04012-00-00

DRILLER'S LOG GILBERT NO. 1

Continental Oil Company, Operator	Section 19, Twp. 9S, 18W.
Garvey Drilling Company, Contractor	Location: SE SE SE
Drilling Commenced: February 23, 1953	County: Rooks County, Kansas
Drilling Completed: March 5, 1953	R.T.D.: 3623
Casing Record: 10 3/4" @ 202' w/150 sax	Elevation: 2188'
5 1/2" @ 3620' w/200 sax	

Figures below indicate bottom of formation:

40 Surface soil	Tops:
150 Sand	Heebner: 3322
630 Blue Shale	Toronto: 3344
730 Sand	Lansing: 3365
850 Shale	Arbuckle: 3619
1260 Sand	
1375 Red Bed	
1540 Red Bed & Shale	
1570 Anhydrite	
1975 Shale & Shells	
2180 Shale and Salt	
2490 Lime & Shale	
2530 Shale	
2725 Lime & Shale	
2760 Lime	
3325 Lime & Shale	
3560 Lime	
3575 Conglomerate	
3583 Lime	
3611 Conglomerate	
3623 Lime	
3623 R.T.D.	

F. L. Dunn
 F. L. Dunn
 District Superintendent

Well P & A 8-1-55

RECEIVED
 STATE CORPORATION COMMISSION
 AUG 25 1955
 CONSERVATION DIVISION
 Wichita, Kansas

8-25-55

PLUGGING
 FILE SEC 19 T 9 R 18 W
 BOOK PAGE 137 LINE 34