

Give All Information Completely  
Make Required Affidavit  
Mail or Deliver Report to:  
Conservation Division  
State Corporation Commission  
800 Bitting Building  
Wichita, Kansas

OR  
FORMATION PLUGGING RECORD

Rooks County, Sec. 22 Twp. 9S Rge. 18 (E) (W)

Location as "NE 1/4 NW 1/4 SW 1/4" or footage from lines SW 1/4 SE 1/4 NE 1/4

Lease Owner Heathman-Honaker Drilling Co., Inc.

Lease Name C. Hilgers Well No. 1

Office Address 509-510 Orpheum Bldg., Wichita, Kansas

Character of Well (completed as Oil, Gas or Dry Hole) dry hole

Date well completed 4-6-1949

Application for plugging filed 4-6-1949

Application for plugging approved 4-6-1949


Plugging commenced 4-6-1949

Plugging completed 4-6-1949

Reason for abandonment of well or producing formation dry in Lansing zones of porosity.

If a producing well is abandoned, date of last production ----- 19

Was permission obtained from the Conservation Division or its agents before plugging was commenced? yes

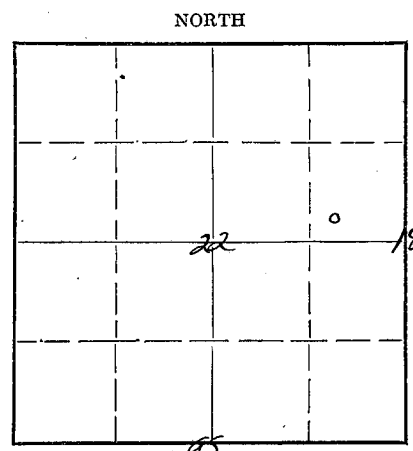

Locate well correctly on above Section Plat

Name of Conservation Agent who supervised plugging of this well C. D. Stough, Box 207, Great Bend, Kansas

Producing formation none Depth to top --- Bottom --- Total Depth of Well 3417 Feet

Show depth and thickness of all water, oil and gas formations.


OIL, GAS OR WATER RECORDS

CASING RECORD

Formation	Content	From	To	Size	Put In	Pulled Out
none	---	---	---	8-5/8" surface w/125 sacks and 1 CC.	181.41' @ 171.47'	None pulled out.
				No oil string run.		

Describe in detail the manner in which the well was plugged, indicating where the mud fluid was placed and the method or methods used in introducing it into the hole. If cement or other plugs were used, state the character of same and depth placed, from ----- feet to ----- feet for each plug set.

Filled hole w/heavy mud to 170'; cemented bottom hole plug w/15 sacks cement; filled hole w/heavy mud to within 30' of top; top hole plug cemented w/10 sacks. Surface pipe cut off 2 1/2' below level of ground.

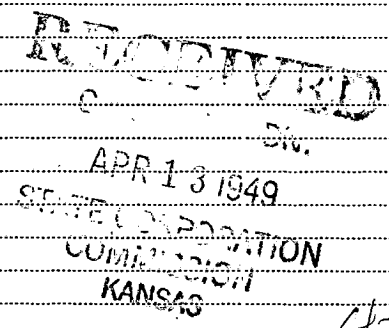

4-13-49

(If additional description is necessary, use BACK of this sheet)

Correspondence regarding this well should be addressed to Heathman-Honaker Drilling Co., Inc., 509-510 Orpheum Building, Wichita 2, Kansas

STATE OF Kansas, COUNTY OF Sedgwick, ss.



H. D. Shreve (employee of owner or owner operator) of the above-described well, being first duly sworn on oath, says: That I have knowledge of the facts, statements, and matters herein contained and the log of the above-described well as filed and that the same are true and correct. So help me God.

(Signature) H. D. Shreve

509-510 Orpheum Bldg., Wichita 2, Kansas (Address)

SUBSCRIBED AND SWORN TO before me this 12th day of April, 1949

June 28, 1952. My commission expires ----- Notary Public.

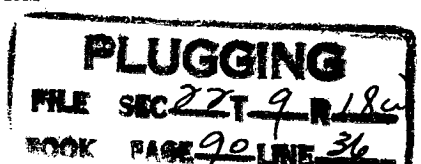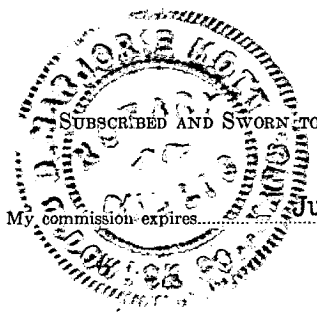

15-163-00198-00-00

C. HILGERS # 1 WELL

Location: Approx. Ctr. SW/4 SE/4 NE/4 Sec.22-9S-18W  
Rooks County, Kansas

Date Spudded: 3-29-49

Operator: Heathman-Honaker Drilling Co., Inc.

Rotary Complete: 4-6-49

Contractor: Heathman-Honaker Drilling Co., Inc.

Elevation: 2131 DF  
2133 KB

Surface Casing: 8 jts. (181.41') 8-5/8" casing  
cemented w/125 sacks, and 1 CC  
@ 171.47'.

TOTAL DEPTH: 3417'

Oil String: None run.  
Dry and abandoned in Lansing-Kansas City @ 3417'

FORMATION TOPS

Anhydrite	1485 (+ 648)
Topeka Limestone	3086 (- 953)
Heebner Shale	3298 (-1165)
Lansing-Kansas City	3338 (-1205)
Total Depth	3417'

LOG

(Figures indicate bottom of formation)

Sand and clay	0 to 40
Sand shale	175
Shale and shells	1090
Sand and shale	1485
Anhydrite	1522
Shale and shells	1570
Shale shells	1820
Shale	1980
Lime and shale	2385
Shale	2452
Lime and shale	3417'
Total Depth	3417'

The undersigned, H. D. Shreve of the Heathman-Honaker Drilling Co., Inc., hereby certifies that the above log is a true and correct log of the formations encountered in drilling the above noted well as reflected by the Daily Drilling Reports.

HEATHMAN-HONAKER DRILLING CO., INC.

BY: H. D. Shreve  
H. D. Shreve

Subscribed and sworn to before me this  
12th day of April, 1949.

D. Marjorie Mot  
Notary Public

My commission expires: June 28, 1952.

APR 13 1949  
STATE COMMISSION  
KANSAS  
4-13-49

**PLUGGING**  
FILE SEC 22-9-18W  
BOOK PAGE 90 LINE 36