


WELL PLUGGING RECORD

Give All Information Completely
Make Required Affidavit
Mail or Deliver Report to:
Conservation Division
State Corporation Commission
800 Bitting Building
Wichita, Kansas

NORTH

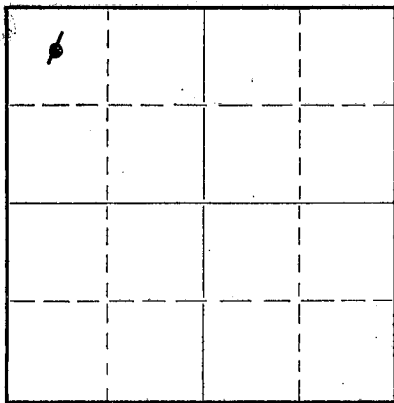

Locate well correctly on above Section Plat

Rooks _____ County, Sec. 30 Twp. 9S Rge. 20 ~~XX~~ (W)
Location as "NE/CNW $\frac{1}{4}$ /SW $\frac{1}{4}$ " or footage from lines NW NW NW
Lease Owner Nadel and Gussman
Lease Name Baldwin Well No. 1
Office Address 1714 First Nat'l Bldg., Tulsa 3, Oklahoma
Character of Well (completed as Oil, Gas or Dry Hole) Oil
Date well completed October 3 19 48
Application for plugging filed November 22 19 55
Application for plugging approved December 7 19 55
Plugging commenced December 4 19 55
Plugging completed December 4 19 55
Reason for abandonment of well or producing formation Depleted
If a producing well is abandoned, date of last production August 19 55
Was permission obtained from the Conservation Division or its agents before plugging was commenced? Yes

Name of Conservation Agent who supervised plugging of this well _____
Producing formation Arbuckle Depth to top 3868' Bottom 3872' Total Depth of Well 3875' Feet
Show depth and thickness of all water, oil and gas formations.

OIL, GAS OR WATER RECORDS

CASING RECORD

Formation	Content	From	To	Size	Put In	Pulled Out
				8 $\frac{1}{4}$ "	134'	None
				5 $\frac{1}{2}$ "	3869'	928' 6"

Describe in detail the manner in which the well was plugged, indicating where the mud fluid was placed and the method or methods used in introducing it into the hole. If cement or other plugs were used, state the character of same and depth placed, from 3875' feet to 3860' feet for each plug set.
Run line and found bottom at 3875'. Filled hole with sand from 3875' to 3860'; placed 3 sacks of cement in hole with dump bailer to form cement plug from 3860' to 3836'. Mudded hole from 3836' to 285'. Ten foot rock bridge installed between 285' and 275' and poured ten sacks of cement to form cement plug and filled hole with mud to 35'. Ten foot rock bridge installed between 35' and 25' and hole capped with ten sacks of cement.

12-20-1955
Tulsa, Kansas

(If additional description is necessary, use BACK of this sheet)

Correspondence regarding this well should be addressed to Nadel and Gussman, 1714 First National Bldg., Tulsa 3, Oklahoma

Plugging Contractor: Barnes & Sons Pipe Pulling Co., Russell, Kansas


STATE OF Oklahoma, COUNTY OF Tulsa, ss.
Herbert Gussman (employee of owner) or (owner or operator) of the above-described well, being first duly sworn on oath, says: That I have knowledge of the facts, statements, and matters herein contained and the log of the above-described well as filed and that the same are true and correct. So help me God.

(Signature) Herbert Gussman
1714 First National Bldg., Tulsa 3, Oklahoma
(Address)

SUBSCRIBED AND SWORN TO before me this 19th day of December, 19 55.

My commission expires April 1, 1957

Jack Brown
Notary Public.

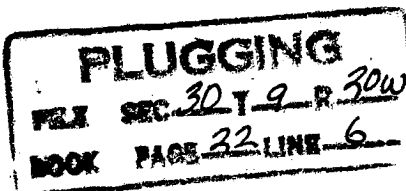

15-163-00148-00-00

WELL LOG

NADEL AND GUSSMAN
1714 First National Building
Tulsa, Oklahoma

Baldwin No. 1

NW Cor. Sec. 30-9-20W
Rooks County, Kansas

Comm. 9-21-48
Comp. 10-3-48

Casing Record: 8" Casing 134'
 cemented 100 sax
 5 1/2" Casing 3869'
 cemented 125 sax

<u>Formation</u>	<u>Depth</u>
Shale and sand	134
Shale, sand and shells	1470
Shale and red bed	1805
Anhydrite	1842
Shale and shells	2250
Shale and Lime	3499
Lime	3808
Shale and lime	3869
Arbukle	3872 T. D.

PLUGGING
 T11 SEC 30 T 9 R 20W
 BOOK PAGE 22 LINE 6