


15-163-00571-00-00

WELL PLUGGING RECORD

Give All Information Completely
Make Required Affidavit
Mail or Deliver Report to:
Conservation Division
State Corporation Commission
800 Bitting Building
Wichita, Kansas

Rooks County. Sec. 30 Twp. 9 Rge. 20 (X) W (W)
Location as "NE/CNW/SW" or footage from lines. SW SW NE
Lease Owner Nadel and Gussman
Lease Name Holler Well No. 1
Office Address P. O. Box 309, Tulsa, Oklahoma
Character of Well (completed as Oil, Gas or Dry Hole) Dry
Date well completed 12-30-52
Application for plugging filed 12-30-52
Application for plugging approved 12-30-52
Plugging commenced 12-30-52
Plugging completed 12-30-52
Reason for abandonment of well or producing formation Dry

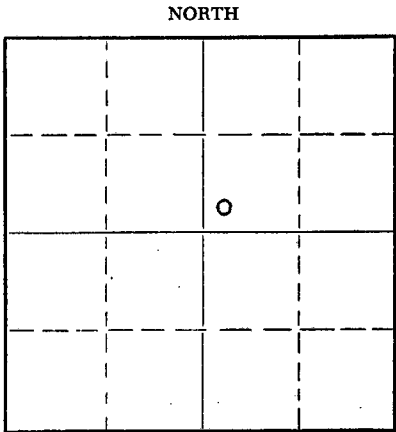

Locate well correctly on above Section Plat

If a producing well is abandoned, date of last production _____ 19____
Was permission obtained from the Conservation Division or its agents before plugging was commenced? Yes

Name of Conservation Agent who supervised plugging of this well Eldon Petty
Producing formation _____ Depth to top _____ Bottom _____ Total Depth of Well 3911 Feet
Show depth and thickness of all water, oil and gas formations.

OIL, GAS OR WATER RECORDS

CASING RECORD

FORMATION	CONTENT	FROM	TO	SIZE	PUT IN	PULLED OUT
				8-3/4	160	0

Describe in detail the manner in which the well was plugged, indicating where the mud fluid was placed and the method or methods used in introducing it into the hole. If cement or other plugs were used, state the character of same and depth placed, from _____ feet to _____ feet for each plug set.

Fill hole with heavy mud T.D. to 155' - set plug and cemented with 15 sacks cement - filled hole to 40', set plug and cemented with 10 sacks cement

STATE CORPORATION COMMISSION
JAN 1 1953
CONS. DIV. 15-163-00571
Wichita, Kansas

(If additional description is necessary, use BACK of this sheet)
Name of Plugging Contractor Reserve Drilling Company
Address 703 Union National Bank Bldg. Wichita 2, Kansas

STATE OF KANSAS, COUNTY OF SEDGWICK, ss.
L. C. Hay (employee of owner) of the above-described well, being first duly sworn on oath, says: That I have knowledge of the facts, statements, and matters herein contained and the log of the above-described well as filed and that the same are true and correct. So help me God.

(Signature) L. C. Hay
703 Union Natl Bk Bldg. Wichita, Kans.
(Address)

SUBSCRIBED AND SWORN TO before me this 5th day of January, 1953
Nola Bandy
Notary Public.

NOTARY PUBLIC
JAN 1 1953
My commission expires Nov. 3, 1956

PLUGGING
FILE SEC 30 T 9 R 20
BOOK PAGE 70 LINE 17

WELL LOG

NADAL AND GUSSMAN

HOLLER WELL #1

SW NE 30-9-20W
Rooks County, Kansas

Comm: 12-17-52
Comp: 12-30-52

Casing: 8-5/8" @ 160' w/80 Sax

Formations	Depth
Shale and sand	140
Shale	160
Shale and shells	975
Shale, sand and shells	1550
Shale and red bed	1803
Anhydrite	1899
Shale	2190
Broken lime and shale	2435
Lime and shale	3633
Lime	3819
Lime and shale	3871
Lime-Conglomerate	3911

GEOLOGICAL TOPS

Heebner Shale	3545
Lansing-Kansas City	3585
Base Kansas City	3802
Conglomerate	3886-3911

STATE OF KANSAS }
COUNTY OF SEDGWICK } SS;

L. C. Hay, of lawful age, deposes and states that the above formations and depths are correct as shown by the daily drilling log on the Holler No. 1 Well in the SW NE of 30-9-20W, Rooks County, Kansas

L. C. Hay

Subscribed and sworn to before me this 6th day of January, 1953.

W. C. Bass
Notary Public

My commission expires Nov. 3, 1956

PLUGGING
FILE SEC 30 T 9 R 2004
BOOK PAGE 26 LINE 14