


Give All Information Completely  
Make Required Affidavit  
Mail or Deliver Report to:  
Conservation Division  
State Corporation Commission  
800 Bittling Building  
Wichita, Kansas

WELL PLUGGING RECORD

Rooks County. Sec. 31 Twp. 9S Rge. 20 (E) (W)

Location as "NE/CNW $\frac{1}{4}$ SW $\frac{1}{4}$ " or footage from lines SE SE NE  
Lease Owner Peel-Hardman Producers, R. W. Shields, H. L. Renner  
Lease Name M. J. Renner Renner "A" Well No. 1  
Office Address P.O. Box 359, Hoisington, Kansas  
Character of Well (completed as Oil, Gas or Dry Hole) Dry Hole  
Date well completed January 11 19 49  
Application for plugging filed January 11 19 49  
Application for plugging approved January 11 19 49  
Plugging commenced January 11 19 49  
Plugging completed January 11 19 49  
Reason for abandonment of well or producing formation Dry Hole

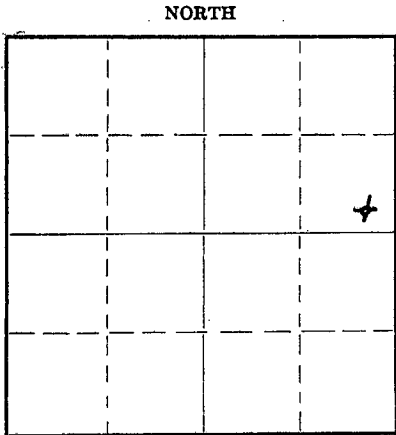

Locate well correctly on above Section Plat

If a producing well is abandoned, date of last production 19  
Was permission obtained from the Conservation Division or its agents before plugging was commenced? Yes

Name of Conservation Agent who supervised plugging of this well C. D. Stough  
Producing formation Depth to top Bottom Total Depth of Well 3925 Feet  
Show depth and thickness of all water, oil and gas formations.

OIL, GAS OR WATER RECORDS

CASING RECORD

Formation	Content	From	To	Size	Put In	Pulled Out
		0	150'	8 5/8"	150'	None

Describe in detail the manner in which the well was plugged, indicating where the mud fluid was placed and the method or methods used in introducing it into the hole. If cement or other plugs were used, state the character of same and depth placed, from feet to feet for each plug set.

3925' - 150 - Heavy Rotary Mud  
150' - 148' - Wooden Plug  
148' - 110 $\frac{1}{2}$ ' - 15 sacks cement  
110 $\frac{1}{2}$ ' - 32' - Heavy Rotary Mud  
32' - 30' - Wooden Plug  
30' - 6' - 10 sacks cement  
6' - Surface - Cellar

JAN 19 1949  
01-19-1949

(If additional description is necessary, use BACK of this sheet)

Correspondence regarding this well should be addressed to Peel-Hardman Producers  
Address P.O. Box 359, Hoisington, Kansas

STATE OF Kansas COUNTY OF Barton ss.  
Glenn Peel Drilling Company, Inc. (employee of owner) or (owner) of the above-described well,

being first duly sworn on oath, says: That I have knowledge of the facts, statements and matters herein contained and the log of the above-described well as filed and that the same are true and correct. So help me God. GLENN PEEL DRILLING COMPANY, INC.

(Signature) BY: *[Signature]*  
P.O. Box 359, Hoisington, Kansas (Address)

SUBSCRIBED AND SWORN TO before me this 18th day of January, 19 49

*[Signature]*  
Notary Public.

My commission expires June 4, 1951

PLUGGING  
FILE SEC 31 T 9 R 200  
BOOK PAGE 79 LINE 47

15-163-00172-00-00

DRILLER'S LOG

Company: Peel-Hardman Producers  
R. W. Shields  
H. L. Renner  
M. J. Renner

Sec. 31 Twp. 9S Rge. 20W  
SE SE NE

County: Rooks,  
Kansas

Farm: Renner "A" Well No. 1

Elevation:

Total Depth: 3925'  
Comm.: 12-31-48 Comp.: 1-11-49  
Contractor: Glenn Peel Drilling Co., Inc.

Production: Dry

Casing:  
8 5/8" 150' cem.

Figures below indicate bottom of formations

Surface Clay	0 -	30
Sand		60
Shale and Shells		150
Shale and Sand		1200
Shale and Shells		1600
Shale, Shells and Red Bed		1790
Shells and Shale		1795
Anhydrite		1825
Shale and Shells		2050
Shale		2235
Shale and Lime		2330
Lime and Shale		2420
Lime		2560
Lime and Shale		2595
Lime		2660
Lime and Shale		2830
Lime and Shale Streaks		2920
Lime and Shale		2930
Lime		3085
Lime and Shale		3170
Lime		3871
Conglomerate		3925
Total Depth		3925

This is to certify that the above information is, to the best of our knowledge, true and correct.


GLENN PEEL DRILLING COMPANY, INC.

BY: J. B. Anderson

SUBSCRIBED AND SWORN to before me this 18th day of January, 1949

My commission expires June 4, 1951

Mania M. Hester  
Notary Public

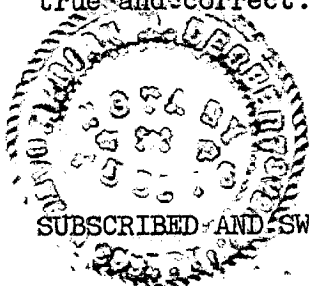

**PLUGGING**  
FILE SEC. 31 T 9 R 20W  
BOOK PAGE 79 LINE 42

RECEIVED  
C-01-19-1949  
JAN 19 1949  
ST. ...  
CO. ...  
...