

WELL PLUGGING RECORD

Give All Information Completely
Make Required Affidavit
Mail or Deliver Report to
Conservation Division
State Corporation Comm.
200 Colorado Derby Bldg.
202 W. 1st St.
Wichita, KS 67202

Rooks County Sec. 17 Twp. 9s Rge. 20 E/W
Location as "NE/CNW/SW" or footage from lines
890' FSL 990' FWL

Lease Owner Liberty Enterprises, Inc.
Lease Name Simoneau "C" Well No. #1
Office Address 308 West Mill Plainville, Ks 67663

Character of Well (Completed as Oil, Gas or Dry Hole)
Dry Hole

Date Well completed October 18 1981

Application for plugging filed October 18 1981

Application for plugging approved October 18 1981


Plugging commenced 7:30 A.M. October 18 1981

Plugging completed 9:00 A.M. October 18 1981

Reason for abandonment of well or producing formation
No Commercial Production

If a producing well is abandoned, date of last production
19

Was permission obtained from the Conservation Division or
its agents before plugging was commenced? Yes

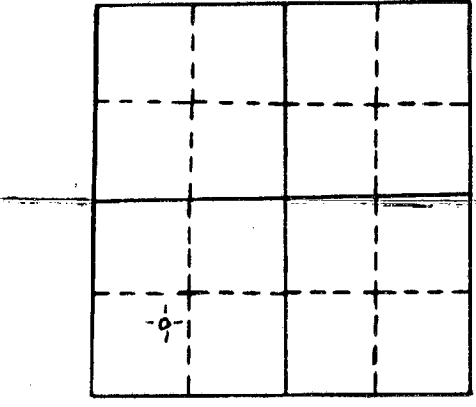

locate well correctly
on above
Section Plot

Name of Conservation Agent who supervised plugging of this well Marion Schmidt
Producing formation Depth to top Bottom Tl. Depth of Well
Show depth and thickness of all water, oil and gas formations.

OIL, GAS OR WATER RECORDS

CASING RECORD

FORMATION	CONTENT	FROM	TO	SIZE	PUT IN	PULLED OUT
Surface Casing	common	0'	200.33'	8 5/8"	200.33'	0'

Describe in detail the manner in which the well was plugged, indicating where the mud fluid was placed and the method or methods used in introducing it into the hold. If cement or other plugs were used, state the character of same and depth placed, from feet to feet for each plug set.

- Plug #1 950' with 70sxs
- Plug #2 200' with 40sxs
- Plug #3 40' with 10sxs

RECEIVED
STATE CORPORATION COMMISSION
11-03-81
NOV 3 1981
CONSERVATION DIVISION
Wichita, Kansas


10sxs in rathole
Total---130sxs 50-50pos
P.D. @ 9:00 A.M.

(If additional description is necessary, use BACK of this sheet)

Name of Plugging Contractor Pioneer Drilling Co
308 West Mill Plainville, Ks 67663

STATE OF Kansas COUNTY OF Rooks, ss.

Liberty Enterprises, Inc. (employee of owner) or (owner or operator) of the above described well, being first duly sworn on oath, says: That I have knowledge of the facts, statements, and matters herein contained and the log of the above described well is filed and that the same are true and correct. So help me God.

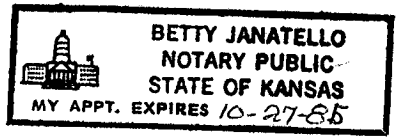

(Signature) David L. Conner
(Address) 308 West Mill Plainville, Ks 67663

SUBSCRIBED AND SWORN TO before me this 2nd day of November, 1981


Betty Janatello
Notary Public

15-163-21400-00-00

WELL LOG

OPERATOR: Liberty Enterprises, Inc.

WELL NAME: Simoneau "C" #1 LOCATION: 890' FSL 990' FWL 17-9s-20W

COUNTY: Rooks STATE: Kansas

WELL COMMENCED: October 10, 1981 WELL COMPLETED: October 18, 1981

ELEVATION: 2259' K.B. TOTAL DEPTH: 3900'

PRODUCTION: D & A RIG NO: #2

CASING - 8 5/8": 5 Jts new 22#-36# set @ 200.33' cemented with 135sxs common 2%gel 3%cc
P.D.@ 6:15 P.M. did circ.
5 1/2": 10-10-81

ALL MEASUREMENTS TAKEN FROM THE TOP OF ROTARY BUSHING:

FROM	TO	FORMATION	DEVIATION FROM VERTICAL	REMARKS:
0'	100'	sand and shale		
100'	210'	sand and shale	210' - 1 degree	
210'	270'	sand and shale		
270'	1215'	sand and shale		
1215'	1759'	sand and shale		
1759'	1785'	anhydrite		
1785'	1800'	anhydrite		
1800'	2200'	sand and shale	2200' - 3/4 degree	
2200'	2420'	shale and lime		
2420'	2627'	lime and shale		
2627'	2850'	lime and shale		
2850'	3037'	lime and shale		
3037'	3192'	lime and shale		
3192'	3295'	lime and shale		
3295'	3457'	lime and shale		
3457'	3558'	lime and shale		
3558'	3623'	lime and shale		
3623'	3700'	lime and shale		
3700'	3740'	lime and shale	3740' - 1 degree	
3740'	3751'	lime and shale		
3751'	3835'	lime and shale		
3835'	3859'	lime and shale		
3859'	3900'	arbuckle		
3900'	R.T.D.			

11/3/81
RECEIVED
STATE CORPORATION COMMISSION
NOV 3 1981
CONSERVATION DIVISION
Wichita, Kansas

STATE OF KANSAS
COUNTY OF

The undersigned hereby certifies that to the best of his knowledge and belief, the above facts are true and correct

PIONEER DRILLING CO., INC.

By Stacy A. Milgus

SUBSCRIBED AND SWORN TO, BEFORE ME, This 2nd day of November, 1981

Betty Janatello
NOTARY PUBLIC

