


WELL PLUGGING RECORD

Give All Information Completely
Make Required Affidavit
Mail or Deliver Report to:
Conservation Division
State Corporation Commission
800 Biting Building
Wichita, Kansas

Rooks County. Sec. 22 Twp. 9 Rge. 20 (W) (W)
Location as "NE/CNW/SW" or footage from lines NW SE SE
Lease Owner Petroleum, Inc.
Lease Name Steeple Well No. 1
Office Address 305 East Third, Wichita 2, Kansas
Character of Well (completed as Oil, Gas or Dry Hole) Dry Hole
Date well completed August 3, 19 53
Application for plugging filed August 3, 19 53
Application for plugging approved August 3, 19 53
Plugging commenced August 3, 19 53
Plugging completed August 3, 19 53
Reason for abandonment of well or producing formation Dry Hole

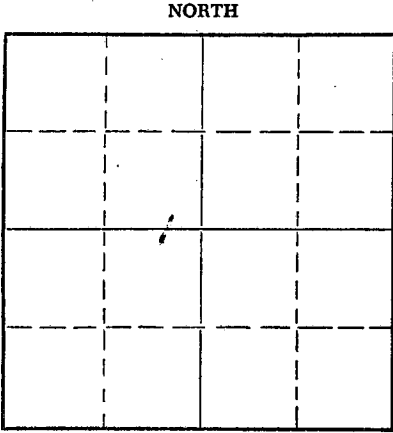

Locate well correctly on above
Section Plat

If a producing well is abandoned, date of last production 19
Was permission obtained from the Conservation Division or its agents before plugging was commenced? Yes

Name of Conservation Agent who supervised plugging of this well Mr. Eldon Petty
Producing formation _____ Depth to top _____ Bottom _____ Total Depth of Well 3,968 Feet
Show depth and thickness of all water, oil and gas formations.

OIL, GAS OR WATER RECORDS

CASING RECORD

FORMATION	CONTENT	FROM	TO	SIZE	PUT IN	PULLED OUT
				8 5/8"	193'	None

Describe in detail the manner in which the well was plugged, indicating where the mud fluid was placed and the method or methods used in introducing it into the hole. If cement or other plugs were used, state the character of same and depth placed, from _____ feet to _____ feet for each plug set.

Mudded up to 180' and set wooden plug
at 180'. Placed 1/2 sack hulls on top
of plug at 180'. Cemented and displaced
15 sacks cement through drill pipe onto
plug at 180'. Mudded up to 40' and set
second wooden plug at 40'. Placed 1/2 sack
hulls on top of plug at 40'. Filled hole
to bottom of well cellar with 10 sacks cement.

Name of Plugging Contractor Garvey Drilling Company
Address R. R. #2, Great Bend, Kansas
(If additional description is necessary, use BACK of this sheet) 08-12-1953

STATE OF KANSAS, COUNTY OF SEDGWICK, ss.
W.W. Fisher (employee of owner) of the above-described well, being first duly sworn on oath, says: That I have knowledge of the facts, statements, and matters herein contained and the log of the above-described well as filed and that the same are true and correct. So help me God.

(Signature) W.W. Fisher
305 East Third, Wichita, Kansas
(Address)

SUBSCRIBED AND SWORN TO before me this 6th day of August, 19 53
Charlotte Weidner
Notary Public.
My commission expires October 13, 1954

PLUGGING
FILE SEC 22 T 9 R 20
BOOK PAGE 120 LINE 14

15-163-00512-00-00
Steeple's ^{KCC} _{ZAP}
DRILLER'S LOG STEEPLE NO. 1

Petroleum, Inc., Operator
Garvey Drilling Company, Contractor
Drilling Commenced: July 23, 1953
Drilling Completed: August 8, 1953
Casing Record: 8 5/8" @ 192' w/135 sax

Section 22, Twp. 9S, Rge. 20W
Location: NW SE SE
County: Rooks
R.T.D.: 3968'
Production: - D & A

Figures below indicate bottom of formation:

130 Surface and Shale
1470 Sand
1778 Anhydrite
2175 Shale & Shells
3790 Lime
3830 Lime & Shale
3945 Conglomerate
3968 Lime

3968 R.T.D.

Tops:

Heebner: 3504 (-1249)
Toronto: 3524 (-1267)
Lansing: 3540 (-1285)
Arbuckle: 3955 (-1700)

I hereby certify that this is a true and correct log of the above mentioned well.

PETROLEUM, INC.

By W. W. Fisher

STATE OF KANSAS)
) SS.
COUNTY OF SEDGWICK)

Subscribed to and sworn to before me, a Notary Public, in said County and State, this 6th day of August, 1953.



Charlotte J. Hise
Notary Public

My commission expires: October 13, 1954

PLUGGING
FLY SEC 22 T 9 R 20W
BOOK PAGE 129 LINE 14

RECEIVED
STATE COMMISSION
AUG 12 1953
CONS. 08-12-1953
Wichita, Kansas