


WELL PLUGGING RECORD

Give All Information Completely
Make Required Affidavit
Mail or Deliver Report to:
Conservation Division
State Corporation Commission
211 No. Broadway
Wichita, Kansas

NORTH

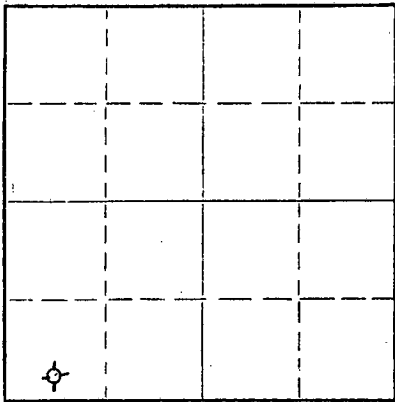

Locate well correctly on above Section Plat

ROOKS County. Sec. 22 Twp. 9 Rge. 20 (E) W (W)
Location as "NE/CNW/SW" or footage from lines DC S LINE SW SW
Lease Owner D. G. Hansen
Lease Name STEEPLES Well No. 1
Office Address LOGAN, KANSAS
Character of Well (completed as Oil, Gas or Dry Hole) Dry Hole
Date well completed February 26 19 56
Application for plugging filed February 26 19 56
Application for plugging approved February 26 19 56
Plugging commenced February 27 19 56
Plugging completed February 27 19 56
Reason for abandonment of well or producing formation Too low structurally

If a producing well is abandoned, date of last production _____ 19____
Was permission obtained from the Conservation Division or its agents before plugging was commenced? Yes

Name of Conservation Agent who supervised plugging of this well Eldon Petty
Producing formation _____ Depth to top _____ Bottom _____ Total Depth of Well 3846 Feet
Show depth and thickness of all water, oil and gas formations.

OIL, GAS OR WATER RECORDS

CASING RECORD

FORMATION	CONTENT	FROM	TO	SIZE	PUT IN	PULLED OUT
				8-5/8"	163'	none

Describe in detail the manner in which the well was plugged, indicating where the mud fluid was placed and the method or methods used in introducing it into the hole. If cement or other plugs were used, state the character of same and depth placed, from _____ feet to _____ feet for each plug set.


Filled hole with heavy mud to 155'. Set plug. Put in 1/2 sack Hulls and 15 sacks cement. Filled with heavy mud up to 40'. Set plug. Filled to top with 1/2 sack Hulls and 10 sacks cement.

(If additional description is necessary, use BACK of this sheet)

Name of Plugging Contractor C-G DRILLING CO.
Address 107 Rule Building

STATE OF KANSAS, COUNTY OF SEDGWICK, ss.
Jay H. Galloway (employee of owner) or (owner or operator) of the above-described well, being first duly sworn on oath, says: That I have knowledge of the facts, statements, and matters herein contained and the log of the above-described well as filed and that the same are true and correct. So help me God.

(Signature) Jay H. Galloway
Jay H. Galloway
107 Rule Bldg.
(Address)

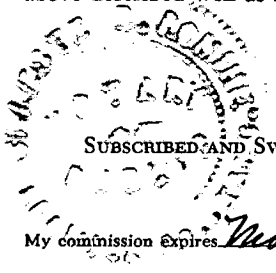

SUBSCRIBED AND SWORN TO before me this 29th day of February, 1956

Celeste Blomine
Notary Public.
STATE CORPORATION COMMISSION

PLUGGING
FILE SEC 22 T 9 R 20W
BOOK PAGE 42 LINE 24

MAR 1 - 1956
03-01-1956
CONSERVATION DIVISION
Wichita, Kansas

15-163-02486-00-00

CONTRACTOR'S WELL LOG

OPERATOR D. G. HANSEN WELL NAME STEEPLES #1

LOCATION C S LINE SW SW Sec. 22-9-20W RIG NO. 1

COUNTY _____ ROOKS STATE KANSAS

COMMENCEMENT DATE FEBRUARY 18, 1956 COMPLETION DATE FEBRUARY 26, 1956

LOG OF WELL

Elevation 2221' rotary bushing.
All measurements taken from the top of rotary bushing.

FROM	TO	FORMATION	DEVIATION FROM VERTICAL	REMARKS
0	163	Surface Soil		
163	500	Shale		
500	1190	Shale-Sand		
1190	1435	Sand		
1435	1540	Red Bed		
1540	1706	Red Bed.		
1706	1745	Anhydrite		
1745	2050	Shale-Shells		
2050	2275	Shale		
2275	2460	Lime-Shale		
2460	2605	Lime-Shale	0° - 2500	
2605	2740	Lime-Shale	0° - 2750	
2740	2830	Lime-Shale		
2830	2955	Lime-Shale		
2955	3085	Lime-Shale	0° - 3000	
3085	3175	Lime-Shale		
3175	3295	Lime-Shale	0° - 3250	
3295	3400	Lime-Shale		
3400	3510	Lime-Shale	0° - 3500	
3510	3619	Lime-Shale		
3619	3725	Lime-Shale		
3725	3830	Lime-Shale	0° - 3750	
3830	3846	Lime-Shale		
	3846	TD		

CASING LEFT IN HOLE AFTER COMPLETION

L163' of 8-5/8" OD Surface Casing

STATE OF KANSAS, COUNTY OF SEDGWICK) ss.

The undersigned hereby certifies that to the best of his knowledge and belief, the above facts are true and correct.

C-G DRILLING CO.

By Jay H. Galloway
Jay H. Galloway

Subscribed and sworn to before me this 29th day of February, 1956.

My commission expires:

March 22, 1956

Celeste B. Brune
Notary Public

PLUGGING
FILE SEC 22 T 9 R 20W
BOOK PAGE 42 LINE 24

CONCE...
Notary Public