


WELL PLUGGING RECORD

Give All Information Completely  
Make Required Affidavit  
Mail or Deliver Report to:  
Conservation Division  
State Corporation Commission  
800 Bitting Building  
Wichita, Kansas

NORTH

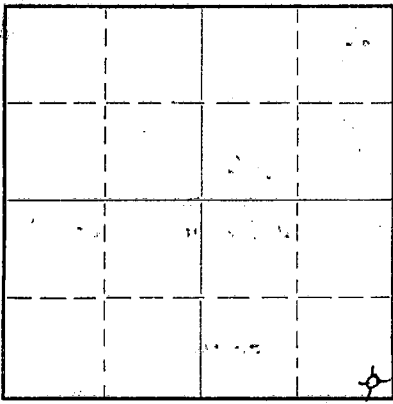

Locate well correctly on above  
Section Flat

Rooks \_\_\_\_\_ County. Sec. 22 Twp. 9<sup>S</sup> Rge. 20 ~~W~~ (W)  
Location as "NE/CNW 1/4 SW 1/4" or footage from lines / SE SE SE  
Lease Owner Wentworth & Sons and John G. Phillips, Jr.  
Lease Name D. J. Steeples Well No. 1  
Office Address Mayo Building; Tulsa, Oklahoma  
Character of Well (completed as Oil, Gas or Dry Hole) Dry Hole  
Date well completed August 27, 1949 19  
Application for plugging filed August 28, 19 49  
Application for plugging approved \_\_\_\_\_ 19  
Plugging commenced August 28, 19 49  
Plugging completed August 28, 19 49  
Reason for abandonment of well or producing formation Dry  
If a producing well is abandoned, date of last production \_\_\_\_\_ 19  
Was permission obtained from the Conservation Division or its agents before plugging was commenced? Yes

Name of Conservation Agent who supervised plugging of this well Mr. Eldon Petty, Box 326; Hays, Kansas  
Producing formation Arbuckle Depth to top 3975' Bottom \_\_\_\_\_ Total Depth of Well 3985' Feet  
Show depth and thickness of all water, oil and gas formations.

OIL, GAS OR WATER RECORDS

CASING RECORD

Formation	Content	From	To	Size	Put In	Pulled Out
				8 5/8	185	None

Describe in detail the manner in which the well was plugged, indicating where the mud fluid was placed and the method or methods used in introducing it into the hole. If cement or other plugs were used, state the character of same and depth placed, from \_\_\_\_\_ feet to \_\_\_\_\_ feet for each plug set.

Hole loaded with mud  
Halliburton Plug Set @ 187'  
15 Sacks Cement Set on top of plug  
Halliburton plug and 10 sacks  
Cement at top of hole

RECEIVED

09-09-1949  
SEP 9 X 1949

STATE CORPORATION  
COMMISSION  
KANSAS

(If additional description is necessary, use BACK of this sheet)

Correspondence regarding this well should be addressed to Claude Wentworth - Mayo Building; Tulsa, Oklahoma  
Address \_\_\_\_\_



STATE OF Oklahoma COUNTY OF Tulsa, ss.  
Claude Wentworth (employee of owner) or (owner or operator) of the above-described well,

being first duly sworn on oath, says: That I have knowledge of the facts, statements, and matters herein contained and the log of the above-described well as filed and that the same are true and correct. So help me God.

(Signature) Claude Wentworth  
Mayo Bldg Tulsa Okla (Address)

SUBSCRIBED AND SWORN TO before me this 8th day of September, 1949

My commission expires May 3, 1951 Cleta Walker Notary Public.

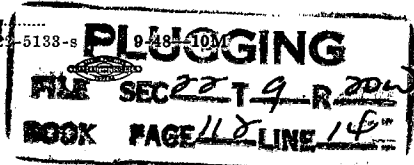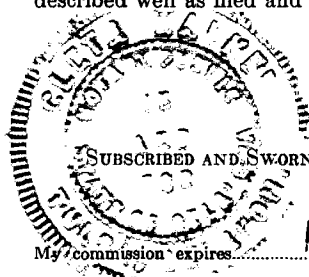

15-163-02520-00-00

KANSAS WELL LOG BUREAU--- KANSAS GEOLOGICAL SOCIETY  
412 UNION NATIONAL BANK BUILDING - WICHITA, KANSAS


COMPANY Wentworth & Sons and John G. Phillips, Jr.

SEC. 22 T. 9<sup>S</sup> R. 20 W  
LOC. SE SE SE

FARM D. J. Steeples NO. 1

TOTAL DEPTH 3985'  
COMM. August 14, 1949 COMP. August 27, 1949  
SHOT OR TREATED  
CONTRACTOR Claude Wentworth Drilling Company  
ISSUED

COUNTY Rooks

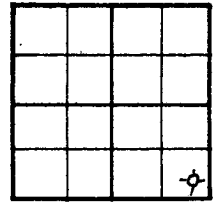

CASING  
20 10  
15 1/2 8 1/4 185'  
12 1/2 6 1/2  
13 3/4 5 1/4

ELEVATION 2273'  
PRODUCTION Dry

FIGURES INDICATE BOTTOM OF FORMATIONS

Surface	0	30
Post Rock and Shale		70
Water Sand		100
Shale and Shells		185
Sandy and Shale		405
Shale, Shells and sand		795
Sand		870
Shale and Shells		955
Sand		1555
Shale		1772
Anhydrite		1815
Shale and Shells		1850
Shale		2050
Lime and Shale		2515
Lime		2680
Shale and Lime		2830
Lime		2915
Lime and Shale		2990
Lime		3060
Lime and Shale		3340
Lime		3405
Lime and Shale		3490
Lime		3545
Lime and Shale		3562
Lime		3758
Lime and Shale		3775
Lime		3812
Shale and Lime		3844
Chirt		3860
Conglomert		3905
Lime and Shale		3950
Lime		3985

T.D.

RECEIVED  
SEP 9 1949  
STATE CORPORATION  
COMMISSION  
KANSAS

PLUGGING  
FILE SEC-22T-9-R-20W  
BOOK PAGE 112 LINE 14