

15-163-20033-00-00

STATE OF KANSAS
STATE CORPORATION COMMISSION

Form CP-4


Give All Information Completely
Make Required Affidavit
Mail or Deliver Report to:
Conservation Division
State Corporation Commission
212 No. Market
Wichita, Kansas

WELL PLUGGING RECORD

Rooks County, Sec. 22 Twp. 9S Rge. (E) 20 (W)
Location as "NE/CNWxSWx" or footage from lines SE SE NW

Lease Owner Robert R. Price
Lease Name Steeples Well No. 1
Office Address 5727 E. 43rd Street - Tulsa, Oklahoma
Character of Well (completed as Oil, Gas or Dry Hole) dry hole
Date well completed 1-30 1967
Application for plugging filed 1-30 1967
Application for plugging approved 1-30 1967
Plugging commenced 3:00 AM 1-30 19 67
Plugging completed 11:45 - 1-30 19 67
Reason for abandonment of well or producing formation Dry

NORTH

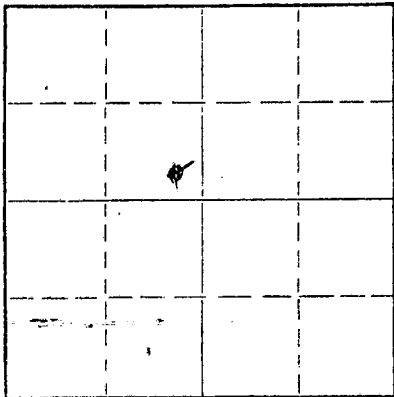

Locate well correctly on above
Section Plat

If a producing well is abandoned, date of last production none 19
Was permission obtained from the Conservation Division or its agents before plugging was commenced? yes

Name of Conservation Agent who supervised plugging of this well Leo Massey - Hays, Kansas
Producing formation none Depth to top Bottom Total Depth of Well 3825 Feet
Show depth and thickness of all water, oil and gas formations.

OIL, GAS OR WATER RECORDS

CASING RECORD

FORMATION	CONTENT	FROM	TO	SIZE	PUT IN	PULLED OUT
Soil Clay & Sand		0	277	12 1/2	277	0

Describe in detail the manner in which the well was plugged, indicating where the mud fluid was placed and the method or methods used in introducing it into the hole. If cement or other plugs were used, state the character of same and depth placed, from feet to feet for each plug set.

Fill hole to 540' Plug and 25 sacks thru pipe fill to 250'
plug and 20 sacks thru pipe fill to 40' plug and hulls bridge to
hold Kelly Wt. Filled rat hole with 2 sacks.

RECEIVED
STATE CORPORATION COMMISSION

FEB 2 1967
02-02-1967
CONSERVATION DIVISION
Wichita, Kansas


(If additional description is necessary, use BACK of this sheet)

Name of Plugging Contractor B & B-DRILLING-INC.
Address 548 PETROLEUM BUILDING WICHITA, KANSAS

STATE OF KANSAS, COUNTY OF SEDGWICK, ss.
BILL LAHAR (employee of owner) or (owner or operator) of the above-described well, being first duly sworn on oath, says: That I have knowledge of the facts, statements, and matters herein contained and the log of the above-described well as filed and that the same are true and correct. So help me God.

(Signature) Bill Lahar
548 PETROLEUM BUILDING - WICHITA, KANSAS
(Address)

SUBSCRIBED AND SWORN to before me this 1st day of February 1967
May 31, 1970

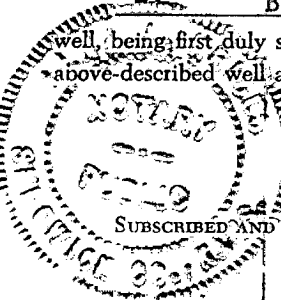

Notary Public.

15-163 - 20003-00-00

B & B DRILLING, INC.

548 Petroleum Building
Wichita, Kansas 67202
January 31, 1967

RECEIVED
STATE CORPORATION COMMISSION

FEB 2 1967
07
CONSERVATION DIVISION
Wichita, Kansas

DRILLERS LOG

COMPANY: ROBERT R. PRICE
CONTRACTOR: B & B DRILLING INC.
TOTAL DEPTH: 3825'
COMMENCED: January 22, 1967
COMPLETED: January 30, 1967

Re: Steeples # 1
SE SE NW
Section 22-9S-20W
Rooks County, Kansas

0	40	Soil Clay & Sand
40	277	Shale Sand & Clay
277	1000	Shale & Red Bed
1000	1685	Clay Shale Sand & Red Bed
1685	1717	Shale & Red Bed
1717	1765	Anhydrite
1765	1800	Shale
1800	2178	Shale
2178	2365	Shale & Lime
2365	2510	Shale & Lime
2510	2675	Lime & Shale
2675	2722	Lime & Shale
2722	2765	Shale
2765	2970	Lime & Shale
2970	3100	Lime & Shale
3100	3255	Shale & Lime
3255	3300	Topeka
3300	3425	Lime & Shale
3425	3473	Lime & Shale
3473	3573	Lansing
3573	3651	Lime
3651	3720	Lime
3720	3795	Lime Shale & ch
3795	3825	Conglomerate
3825		Total Depth D & A

We certify the above and foregoing to be true and correct copy of the log on the #1 Steeples, located in Rooks County, Kansas.

B & B DRILLING INC.
Bill Labor President

Alma A. Neises Notary Public
Subscribed and sworn to before me this
1st day of February, 1967
My commission expires May 31, 1970

