


15-163-20329-00-00

STATE OF KANSAS
STATE CORPORATION COMMISSION

WELL PLUGGING RECORD

Give All Information Correctly
Make Required Affidavit
Mail or Deliver Report to:
Conservation Commission
State Ch. Market, Insurance Bldg.
Wichita, Kansas

NORTH

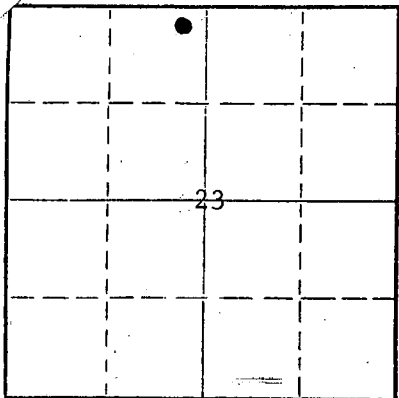

Locate well correctly on above
Section Plat

Rooks County, Sec. 23 Twp. 9S Rge. (E) 20 (W)

Location as "NE/CNW/SW" or footage from lines NE NE NW
Lease Owner John O. Farmer, Inc.
Lease Name Steeples Well No. #1
Office Address P.O. Box 352, Russell, KS 67665
Character of Well (completed as Oil, Gas or Dry Hole) Oil
Date well completed October 28, 1970
Application for plugging filed July 14, 1980
Application for plugging approved July 15, 1980
Plugging commenced July 21, 1980
Plugging completed July 21, 1980
Reason for abandonment of well or producing formation fluid exhausted

If a producing well is abandoned, date of last production August, 1979
Was permission obtained from the Conservation Division or its agents before plugging was commenced? Yes

Name of Conservation Agent who supervised plugging of this well Marion Schmidt
Producing formation Arbuckle Depth to top 3699 Bottom 3733 Total Depth of Well 3733 Feet
Show depth and thickness of all water, oil and gas formations.


OIL, GAS OR WATER RECORDS

CASING RECORD

FORMATION	CONTENT	FROM	TO	SIZE	PUT IN	PULLED OUT
				8-5/8"	200'	None
				5-1/2"	3730'	None
8-5/8" surface casing cemented with 130 sx. (circulated)						
5-1/2" on bottom with 125 sx. and through DV tool at 1699' with 475 sx.						

Describe in detail the manner in which the well was plugged, indicating where the mud fluid was placed and the method or methods used in introducing it into the hole. If cement or other plugs were used, state the character of same and depth placed, from _____ feet to _____ feet for each plug set.

Mixed 35 sx. cement with 1 sx. hulls and pumped down annulus and shut in @ 300# pressure. Mixed 3 sx. hulls, 20 sx. gel, 2 sx. hulls, released plug and mixed rest of cement. Shut in @ 700# pressure.

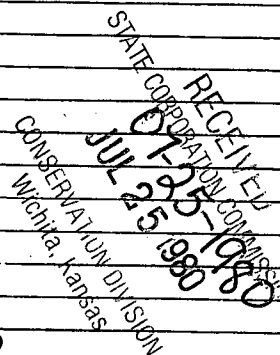

(If additional description is necessary, use BACK of this sheet)

Name of Plugging Contractor Allied Cementing Company, Inc.
Address Russell, KS 67665

STATE OF Kansas COUNTY OF Russell, ss.
John O. Farmer (employee of owner) or (owner or operator) of the above-described well, being first duly sworn on oath, says: That I have knowledge of the facts, statements, and matters herein contained and the log of the above-described well as filed and that the same are true and correct. So help me God.

(Signature) John O. Farmer
P.O. Box 352, Russell, KS 67665 (Address)

SUBSCRIBED AND SWORN TO before me this 24th day of July, 1980

Connie Lynn Anderson
Notary Public.

March 29, 1983

