

STATE OF KANSAS
STATE CORPORATION COMMISSION


15-143-00804-00-00

WELL PLUGGING RECORD

Give All Information Completely
Make Required Affidavit
Mail or Deliver Report to:
Conservation Division
State Corporation Commission
212 North Market, Insurance Bldg.
Wichita, Kansas

Rooks County, Sec. 25 Twp. 9S Rge. 20W (E) (W)
Location as "NE/CNW&SW" or footage from lines. SE NW SE
Lease Owner Davis Bros. - Transit Corporation
Lease Name Steeples "G" Well No. 1
Office Address 1516 Liberty Bank Bldg., Oklahoma City, Oklahoma
Character of Well (completed as Oil, Gas or Dry Hole) Dry hole
Date well completed March 27 1961
Application for plugging filed March 27 1961
Application for plugging approved March 27 1961
Plugging commenced March 27 1961
Plugging completed March 27 1961
Reason for abandonment of well or producing formation No production

NORTH

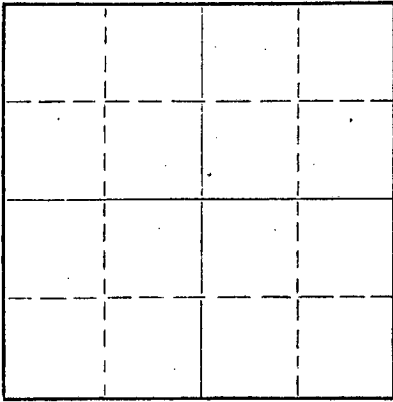

Locate well correctly on above Section Plat

If a producing well is abandoned, date of last production 19
Was permission obtained from the Conservation Division or its agents before plugging was commenced?

Name of Conservation Agent who supervised plugging of this well Eldon Petty, Box 326, Hays, Kansas
Producing formation Depth to top Bottom Total Depth of Well Feet
Show depth and thickness of all water, oil and gas formations.

OIL, GAS OR WATER RECORDS

CASING RECORD

FORMATION	CONTENT	FROM	TO	SIZE	PUT IN	PULLED OUT
				8 5/8"	219'	None

Describe in detail the manner in which the well was plugged, indicating where the mud fluid was placed and the method or methods used in introducing it into the hole. If cement or other plugs were used, state the character of same and depth placed, from feet to feet for each plug set.

Filled hole with heavy drilling mud to 550', set plug, cemented with 20 sacks of cement
Filled hole with heavy drilling mud to 185', set plug, cemented with 20 sacks of cement
Filled hole with heavy drilling mud to 40', set plug, cemented with 10 sacks of cement to bottom of cellar

RECEIVED
STATE CORPORATION COMMISSION
APR 19 1961
04-19-1961
CONSERVATION DIVISION
Wichita, Kansas

(If additional description is necessary, use BACK of this sheet)

Name of Plugging Contractor Transit Corporation
Address 1516 Liberty Bank Building, Oklahoma City, Oklahoma

STATE OF Oklahoma, COUNTY OF Oklahoma, ss.
Paul E. Gathers (employee of owner) or (owner or operator) of the above-described well, being first duly sworn on oath, says: That I have knowledge of the facts, statements, and matters herein contained and the log of the above-described well as filed and that the same are true and correct. So help me God.


(Signature) Paul E. Gathers

(Address)

SUBSCRIBED AND SWORN to before me this 14th day of April, 19 61

Helen M. Anderson
Notary Public.

My commission expires March 10, 1965

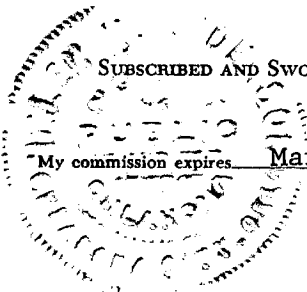

15-163-00804-00-00

DRILLER'S WELL LOG

Davis Bros. - Transit Corporation

Steeple's "G" # 1 well located in
SE NW SE, Section 25-9S-20W
Rooks County, Kansas

Commenced: March 16, 1961
Completed: March 27, 1961
Elevation: 2222' K.B.

Casing 8 5/8" @ 219'
Cemented w/135 sacks

<u>Formation</u>	<u>From</u>	<u>To</u>
Surface clay	0	20
Sand	20	39
Shale	39	90
Sand	90	155
Shale	155	219
Shale and shells	219	740
Sand	740	975
Shale and shells	975	1450
Shale and redbed	1450	1665
Anhydrite	1665	1702
Shale	1702	1925
Shale and shells	1925	2190
Pyrite and lime	2190	2215
Lime and shale	2215	2445
Lime	2445	2550
Lime and shale	2550	2925
Lime	2925	3125
Lime and shale	3125	3231
Topeka lime	3231	3315
Lime	3315	3436
Heebner	3436	3450
Lime	3450	3486
Lime and chert	3486	3566
Pyrite	3566	3578
Lime	3578	3700
Lime and Conglomerate chert	3700	3735
Conglomerate chert	3735	3772
Simpson Dolomite	3772	3782
Arbuckle	3782	3791 TD

RECEIVED
STATE CORPORATION COMMISSION

APR 19 1961

CONSERVATION DIVISION
Wichita, Kansas

I hereby certify the foregoing to be a true and correct Driller's Log of the formations encountered in the above well.

Subscribed and sworn to before me
this 14th day of April, 1961

TRANSIT CORPORATION

By Paul E. Gathers

My commission expires 3-10-65

Helen M. Anderson
Notary Public