

15-065-02279-00-00

WELL PLUGGING RECORD

24

12

Graham County. Sec. 24 Twp. 9S Rge. (E) 21 (W)

Location as "NE/CNW¼SW¼" or footage from lines SE/4 NE/4 SE/4

Lease Owner Skelly Oil Company

Lease Name Flora Barry Well No. 2

Office Address Box 1650, Tulsa, Oklahoma

Character of Well (completed as Oil, Gas or Dry Hole) Dry Hole

Date well completed July 5, 1949

Application for plugging filed July 7, 1949

Application for plugging approved July 8, 1949

Plugging commenced August 2, 1949

Plugging completed August 9, 1949

Reason for abandonment of well or producing formation Dry Hole

If a producing well is abandoned, date of last production..... 19.....
Was permission obtained from the Conservation Division or its agents before plugging was com-
menced? Yes

OIL, GAS OR WATER RECORDS

CASING RECORD

[illegible]

Describe in detail the manner in which the well was plugged, indicating where the mud fluid was placed and the method or methods used in introducing it into the hole. If cement or other plugs were used, state the character of same and depth placed, from.....feet tofeet for each plug set.

13 gallons of plastic	3835'	to	3831'
Bridging plug			3630'
Sand and rock	3630'	to	3605'
5 sacks of cement	3605'	to	3565'
Mud laden fluid	3565'	to	299'
Bridged hole w/ rock			299'
15 sacks of cement	299'	to	253'
Mud laden fluid	253'	to	30'
10 sacks of cement	30'	to	6'
Surface soil	6'	to	0'

RECEIVED

AUG 31 1949

8-31-49

STATE CORPORATION
REGISTRATION

(If additional description is necessary, use BACK of this sheet)

Correspondence regarding this well should be addressed to Skelly Oil Company
Address Box 391
Hutchinson, Kansas

STATE OF Kansas, COUNTY OF Reno, ss.
H. E. Wamsley (employee of owner) ~~NOT A MEMBER OF THE BOARD~~ of the above-described well,
being first duly sworn on oath, says: That I have knowledge of the facts, statements, and matters herein contained and the log of the above-described well as filed and that the same are true and correct. So help me God.

(Signature) _____

Box 391, Hutchinson, Kansas
(Address)

SUBSCRIBED AND SWORN to before me this 30th day of August, 19 49


My commission expires: April 7, 1951

22-5133-s 9-48-10M

PLUGGING
FILE SEC 24 T 9 R 2/4
BOOK PAGE 104 LINE 23

15-065-02279-00-00

SKELLY OIL COMPANY

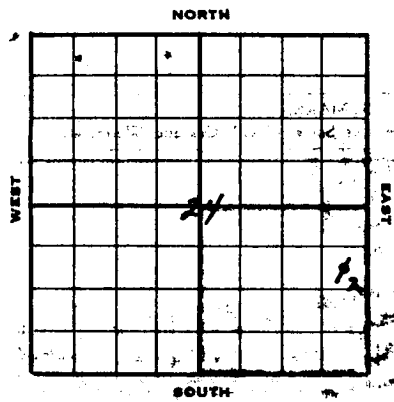

Well Record

Lease Name and No. **Flores Barry #39437** Well No. **2** Elev. **2245' BM**
Lease Description **SE/4 of Section 24-9S-21W,**
Graham County, Kansas
Location made **May 10, 1949** by **P. J. Cussen**
990 feet from North line **330** feet from East line **SE/4**
feet from South line feet from West line of **Sec. 24**

Work com'd **5/15** 19**49** Rig comp'd **5/17** 19**49** Drlg. com'd **5/17** 19**49** Drlg. comp'd **6/1** 19**49**
Rig Contractor **Claude Postworth Drilling Co., Inc.**
Drilling Contractor **Claude Postworth Drilling Co., Inc., Tulsa, Oklahoma**
Rotary Drilling from **Top** to **3835'** Cable Tool Drilling from **To complete** to
Commenced Producing **DRY HOLE** 19 Initial Prod. before shot or acid Bbls.
Initial Prod. after shot or acid Bbls.
Dry Gas Well Press Volume Cu. ft.
Casing Head Gas Pressure Volume Cu. ft.
Braden Head **(8-5/8" 255" OD)** Gas Pressure Volume Cu. ft.
Braden Head **(5")** Gas Pressure Volume Cu. ft.

PRODUCING FORMATION **DRY HOLE** (Name) Top Bottom TOTAL DEPTH **3835'**

CASING RECORD

Size	Wt.	Thds.	Where Set	PULLED OUT			LEFT IN			KIND	Cond'n	CEMENTING	
				Jts.	Feet	In.	Jts.	Feet	In.			Sacks Used	Method Employed
8-5/8"	32	85	299'				10	295	6	355 H2 REV A		150	Halliburton
5-1/2"	15 1/2	82	3027'	82	2636	0	38	1201	0	355 R2 SS A		200	Halliburton
Lot #76													
(8-5/8" OD casing set 6' in cellar and 5 1/2" cased to derrick floor)													
Used 1 - 5 1/2" OD Larkia Combination Guide & Float Check													

Liner Set at Length Perforated at
Liner Set at Length Perforated at
Packer Set at Size and Kind
Packer Set at Size and Kind

SHOT OR ACID TREATMENT RECORD

	FIRST	SECOND	THIRD	FOURTH
Date	6/21/49	6/26/49	7/2/49	
Acid Used	300	250	300	
Size Shot	3/8"	3/8"	3/8"	
Shot Between	3823 Ft. and 3827 Ft.	3823 Ft. and 3827 Ft.	3823 Ft. and 3826 Ft.	Ft. and Ft.
Size of Shell				
Put in by (Co.)	Dowell Inc.	Dowell Inc.	Dowell Inc.	
Length anchor				
Distance below Cas'g				
Damage to Casing or Casing Shoulder				

SIGNIFICANT GEOLOGICAL FORMATIONS

NAME	Top	Bottom	GAS		OIL		REMARKS
			From	To	From	To	
Coarner Shale	3488'						
Oronto Lina	3514'						
Shaling Lina	3528'						
Shalemate	3714'						
Lapona Shale	3814'						
Truckle Lina	3826'				3826'	3829'	Fair por. and saturation
					3829'	3835'	Poor to fair por. & sat.

CLEANING OUT RECORDS

	DATE COMMENCED	DATE COMPLETED	PROD. BEFORE	PROD. AFTER	REMARKS
1st					See Reverse for other details.
2nd					" " " " "
3rd					" " " " "
4th					" " " " "

PLUGGING BACK AND DEEPENING RECORDS

	Date Commenced	Date Completed	No. Feet Plugged Back or Deepened	Prod. Before	Prod. After	REMARKS
1st						See Reverse for other details.
2nd						" " " " "
3rd						" " " " "
4th						" " " " "

(See Reverse for Record of Formation)

YMA9MOO RECORD OF FORMATIONS

FORMATION	TOP	BOTTOM	REMARKS
Surface soil and sand	0	10	
Sand	10	100	
Sand and gravel	100	200	
Sand, shells and sand rock	200	300	Set and cemented 8-5/8" OD, 32 ft. BR thd., J-55, H-2, R.S.C. steel casing at 299' with 120 sacks of cement and 5 sacks of aquagel.
Drilled 12-1/4" hole			
Shale	300	625	
Shale and sand	625	680	
Shale	680	935	
Sand	935	1300	
Sand and red bed	1300	1755	
Anhydrite	1755	1805	
Shale	1805	1840	
Shale and lime shells	1840	2045	
Shale	2045	2200	
Shale and lime	2200	2595	
Shale	2595	2640	
Lime and shale	2640	3794	
Conglomerate	3794	3814	
Shale	3814	3826	

TOP HEADLINE SHALE 1408'
 TOP TORONTO LINE 3514'
 TOP L. HILLS LINE 3528'
 TOP CONGLOMERATE 3794'
 TOP SILVER SHALE 3814'
 TOP ARSENAL LINE 3826'

Fine to medium crystalline dolomite	3826	3829	Fair porosity and saturation
Fine to coarse crystalline dolomite	3829	3835	Poor to fair porosity and saturation
TOTAL DEPTH DRILLED		3855'	

Run Halliburton drill stem test with packer set at 3827', open 30 minutes and recovered 33' of drilling mud with show of free oil, S.M.R.-750'.

Set and cemented 2-1/2" OD, 15.37, OK thd., J-55, H-2, Seamless steel casing (Lot #76) at 3827' with 200 sacks of cement and 4 sacks of aquagel. Finished cementing at 3:00 P.M. 6/1/49.

Moved in and rigged up cable tools on June 17, bailed the hole dry and 5/8" casing tested OK. Drilled cement plug and cleaned out to bottom. 20' water in hole in 1 hour; tested 12 hours, 2-1/2 gallons of water with slight seep of oil per hour.

On June 19, plugged back with 8 gallons of Dowell plastic from 3835' to 3831' at 1100' pressure. On June 20, perforated 5/8" casing from 3825' to 3827' with 36 holes by Lamb-wells, no increase in fluid. Ran 2" tubing and treated with 300 gallons of Dowell "2-18 3-17" acid as follows:

ACID TREATMENT NO. 1 - Between 3823' and 3827'

Treatment put in 6/21/49 by Dowell Inc., using 300 gallons of acid and 30 barrels of oil to fill hole and flush.

TIME	SE	RE	REMARKS
1:02 am			Filled hole with 37 barrels of oil
1:05 am			Start acid down tubing
1:25 am			Acid on bottom
1:30 am	300'		Start flush
3:00 am	500'		1 1/2 barrels of oil in hole to flush
3:20 am	500'		6 barrels of oil in hole to flush
3:40 am	500'		Flushed hole with 7 barrels of oil and treatment completed.

Swabbed out 91 barrels of oil (used in treating) and 20 barrels of water. Ran rods and PDS 11 hours, 4 barrels of oil and 20 barrels of water. On June 23, PDS 4 hours, 1/4 barrel of oil and 11 barrels of water. Pulled rods and tubing and plugged back with 32 gallons of Dowell plastic from 3831' to 3828' with 300' Gr.

On June 26, bailed the hole dry, ran 2" tubing and treated with 250 gallons of Dowell "2-18 3-17" acid as follows:

ACID TREATMENT NO. 2 - Between 3829' and 3827'

Treatment put in 6/26/49 by Dowell Inc., using 250 gallons of acid and 30 barrels of oil to fill hole and flush.

TIME	SE	RE	REMARKS
7:12 am			Filled hole with 30 barrels of oil
7:17 am			Start acid
7:35 am	150'	0'	Acid on bottom
9:00 am	400'	300'	42 gallons of acid in formation
9:30 am	450'	350'	54 gallons of acid in formation
10:10 am	500'	425'	126 gallons of acid in formation
10:30 am	500'	490'	187 gallons of acid in formation
11:00 am	450'	450'	250 gallons of acid in formation
			Flushed hole with 6 barrels of oil and treatment completed.

Swabbed out oil used in treating and 5 barrels of water, ran rods

and PGB 8 hours, 18 barrels of oil and 1 barrel of water. On June 28, PGB 8 hours, 1/2 barrel of oil and 12 barrels of water. Pulled rods and tubing and drilled plastic plug from 3828' to 3831', loaded hole and plugged back with 5 gallons of Dowell plastic from 3831' to 3826' at 10259 CP.

Bailed the hole dry on June 30, then bailed and tested 6 hours, 6 barrels of water with a scum of oil per hour. On July 1, ran 2" tubing and treated with 300 gallons of Dowell "XXF-18 W-17" acid as follows:

ACID TREATMENT NO. 3 - Between 3823' and 3826'

Treatment put in 7/2/49 by Dowell Inc., using 300 gallons of acid and 81 barrels of oil to fill hole and flush.

TIME	CP	TP	REMARKS
3:12 am			Filled hole with 74 barrels of oil
3:16 am			Start acid
3:33 am	150%	0%	Acid on bottom, start flush
4:00 am	400%	300%	31 gallons of acid in formation
4:25 am	350%	275%	115 gallons of acid in formation
4:45 am	250%	200%	199 gallons of acid in formation
5:00 am	175%	175%	300 gallons of acid in formation
			Flushed hole with 7 barrels of oil and treatment completed.

Swabbed out oil used in treating, then swabbed through 2" tubing 9 hours, 23 barrels of water with rainbow show of oil. Pulled rods and tubing and set Lane-bells bridging plug at 3630', bailed hole dry; then perforated 5 1/2" casing from 3609' to 3616' with 65 holes by Lane-bells, show of water from 3610' to 3612'. Bailed and tested 6 hours, no oil and 3 barrels of water per hour. On July 6, regular authority was granted to plug and abandon the well.

Moved in plugging machine on August 3, 1949, and plugged the well as follows:

Sand and rock	3630' to 3605'
5 sacks of cement	3605' to 3565'
And laden fluid	3565' to 299'
Bridged hole w/ rock	299'
15 sacks of cement	299' to 253'
And laden fluid	253' to 30'
10 sacks of cement	30' to 6'
Surface soil	6' to 0'

Plugged and abandoned August 9, 1949.

* Shot off 5 1/2" casing at 3560', unable to pull. Spotted 20 barrels of oil behind 5 1/2" casing, unable to pull; shot off casing at 2702', unable to pull. Shot off casing at 2638' and pulled 81 joints (2656') of 5 1/2" casing.

SLOPE TEST DATA: Tests were taken at 250' intervals from 250' to 3740' inclusive, with no deviation from vertical noted.

WATER ANALYSIS

Skelly Oil Company Pawhuska Research Laboratory
Sample Serial No. 4281 Analysis No. 1567

Water from formation depth 3831'

Date received: 6/29/49

Analysis Completed 7/1/49

	Parts per Million	Grains per Gallon
Total dissolved solids.	49,670	2890
Chlorides as Cl	27,480	1600
Chlorides as NaCl	45,300	2610
Sulfate as SO ₄	1,711	99.5
Sulfate as CaSO ₄	2,429	144.0

