


Give All Information Completely  
Make Required Affidavit  
Mail or Deliver Report to:  
Conservation Division  
State Corporation Commission  
800 Biting Building  
Wichita, Kansas

WELL PLUGGING RECORD

15-065-02934-00-00

NORTH

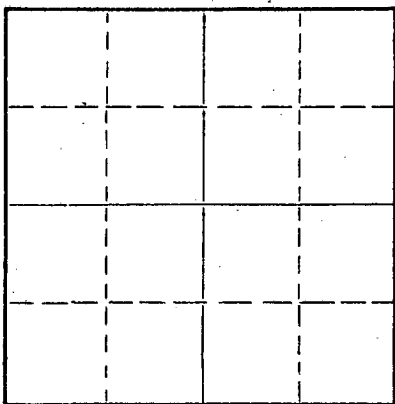

Locate well correctly on above  
Section Plat

Graham County, Sec. 25 Twp. 9 Rge. 21 (E) (W)

Location as "NE/CNW/SW" or footage from lines SE SW NW  
Lease Owner Cooperative Refinery Association  
Lease Name Fesler "A" Well No. 5  
Office Address Box 765 Gt. Bend, Kansas  
Character of Well (completed as Oil, Gas or Dry Hole) oil well  
Date well completed February 23 19 50  
Application for plugging filed August 10 19 56  
Application for plugging approved August 10 19 56  
Plugging commenced Sept. 6 19 56  
Plugging completed Sept. 11 19 56  
Reason for abandonment of well or producing formation non commercial production

If a producing well is abandoned, date of last production November 19 55  
Was permission obtained from the Conservation Division or its agents before plugging was commenced? yes

Name of Conservation Agent who supervised plugging of this well Eldon Petty  
Producing formation Arbuckle dolomite Depth to top \_\_\_\_\_ Bottom \_\_\_\_\_ Total Depth of Well 3797 Feet  
Show depth and thickness of all water, oil and gas formations.

OIL, GAS OR WATER RECORDS

CASING RECORD

FORMATION	CONTENT	FROM	TO	SIZE	PUT IN	PULLED OUT
				10 3/4"	224'	-0-
				6 5/8"	3774	925'6"

Describe in detail the manner in which the well was plugged, indicating where the mud fluid was placed and the method or methods used in introducing it into the hole. If cement or other plugs were used, state the character of same and depth placed, from \_\_\_\_\_ feet to \_\_\_\_\_ feet for each plug set.

T.D. 3797. Dumped 5 sacks cement, top of cement 3767. Pulled casing. Mudded hole to 224'. Set 10 foot rock bridge, top of bridge 214'. Dumped 20 sx. cement, top of cement 174'. Mudded hole to 35'. Dumped 10 sacks cement for top and cap.

Name of Plugging Contractor Charles Wilson (If additional description is necessary, use BACK of this sheet)  
Address 2921 Bonita Gt. Bend, Kansas

STATE OF KANSAS COUNTY OF BARTON, ss.  
Jim Robinson

(employee of owner) or (owner or operator) of the above-described well, being first duly sworn on oath, says: That I have knowledge of the facts, statements, and matters herein contained and the log of the above-described well as filed and that the same are true and correct. So help me God.

(Signature) Jim Robinson  
Box 765 Gt. Bend, Kansas (Address)

SUBSCRIBED AND SWORN to before me this 13 day of September, 19 56

September 2, 1959



Ruth Above Notary Public.

PLUGGING  
FILE SEC 25 T 9 R 21 W  
BOOK PAGE 88 LINE 33

RECEIVED  
STATE CORPORATION COMMISSION  
SEP 14 1956  
CONSERVATION DIVISION  
Wichita, Kansas