


15-065-20712-00-00

STATE OF KANSAS
STATE CORPORATION COMMISSION

Give All Information Completely
Make Required Affidavit
Mail or Deliver Report to:
Conservation Division
State Corporation Commission
P. O. Box 17027
Wichita, Kansas 67217
NORTH

WELL PLUGGING RECORD

GRAHAM County, Sec. 11 Twp. 9S Rge. (E) 22 (W)
Location in "NE/CNWKSW" or footage from lines N/2 NW/4 NW/4
Lease Owner C-G DRILLING CO & H ROSEN OIL CO
Lessor Name VAN LOENEN Well No. 1
Office Address 1107 UNION NATIONAL BUILDING, WICHITA, KS.
Character of Well (completed as Oil, Gas or Dry Hole) DRY HOLE
Date well completed SEPTEMBER 21 19 74
Application for plugging filed SEPTEMBER 21 19 74
Application for plugging approved SEPTEMBER 21 19 74
Plugging commenced SEPTEMBER 21 19 74
Plugging completed SEPTEMBER 21 19 74
Reason for abandonment of well or producing formation TOO LOW STRUCTURALLY

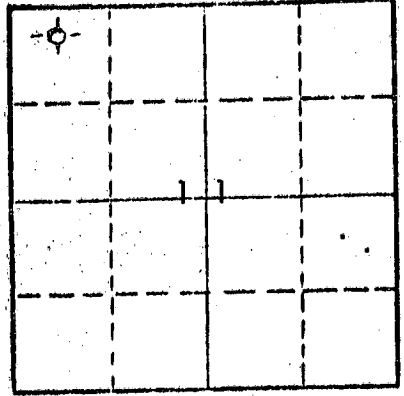

Locate well correctly on above Section Plat

If a producing well is abandoned, date of last production 19
Was permission obtained from the Conservation Division or its agents before plugging was commenced? YES
Name of Conservation Agent who supervised plugging of this well LEO F MASSEY, HAYS, KANSAS
Producing formation _____ Depth to top _____ Bottom _____ Total Depth of Well 3640 Feet
Show depth and thickness of all water, oil and gas formations.

OIL, GAS OR WATER RECORDS

CASING RECORD

FORMATION	CONTENT	FROM	TO	SIZE	PUT IN	PULLED OUT
				8 5/8"	207.22	NONE

Describe in detail the manner in which the well was plugged, indicating where the mud fluid was placed and the method or methods used in introducing it into the hole. If cement or other plugs were used, state the character of same and depth placed, from _____ feet to _____ feet for each plug set.


FILLED WITH HEAVY MUD TO 875'. SET PLUG. PUT IN 100 SACKS CEMENT. FILLED WITH HEAVY MUD TO 215'. SET PLUG. PUT IN 30 SACKS CEMENT. FILLED WITH HEAVY MUD TO 40'. SET PLUG. FILLED TO TOP WITH 10 SACKS CEMENT.

RECEIVED
STATE CORPORATION COMMISSION
OCT 4 1974
CONSERVATION DIVISION
Wichita, Kansas
10-4-74

(If additional description is necessary, use BACK of this sheet)

Name of Plugging Contractor C-G DRILLING CO.
Address 1107 UNION NATIONAL BUILDING, WICHITA, KANSAS 67202

STATE OF KANSAS, COUNTY OF SEDGWICK, ss.
G. F. Galloway (employee of owner) or (owner or operator) of the above-described well, being first duly sworn on oath, says: That I have knowledge of the facts, statements, and matters herein contained and the log of the above-described well as filed and that the same are true and correct. So help me God.
(Signature) G. F. Galloway
1107 Union National Bldg.
(Address)

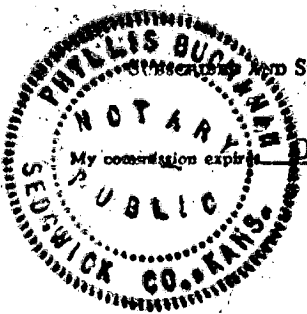

SWORN to before me this 21st day of September, 1974
Phyllis Buchanan
Notary Public.