


STATE OF KANSAS
 STATE CORPORATION COMMISSION
 Give All Information Completely
 Make Required Affidavit
 Mail or Deliver Report to:
 Conservation Division
 State Corporation Commission
 800 Bitting Building
 Wichita, Kansas

OR
FORMATION PLUGGING RECORD

Strike out upper line
 when reporting plug-
 ging off formations.

NORTH

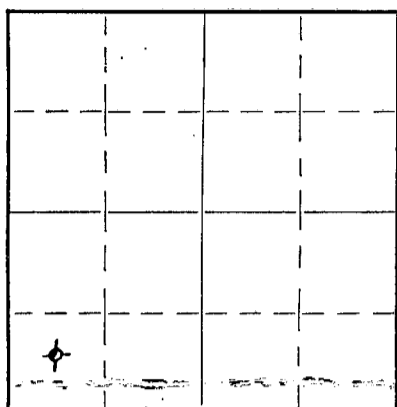

Locate well correctly on above
 Section Plat

Graham County. Sec. 12 Twp. 9 Rge. (E) 22 (W)
 Location as "NE 1/4 NW 1/4 SW 1/4" or footage from lines. Center of SW of SW
 Lease Owner. Sharon Drilling Co
 Lease Name. Bundy Well No. 1
 Office Address. 352 N. Broadway, Wichita, Kansas.
 Character of Well (Completed as Oil, Gas or Dry Hole). Dry Hole
 Date, well completed. 2-16-41 193
 Application for plugging filed. 2-19-41 193
 Application for plugging approved. 2-19-41 193
 Plugging Commenced. 2-22-41 193
 Plugging Completed. 2-25-41 193
 Reason for abandonment of well or producing formation. Dry hole

If a producing well is abandoned, date of last production. 193
 Was permission obtained from the Conservation Division or its agents before plugging was com-
 menced? Yes

Name of Conservation Agent who supervised plugging of this well. W. T. Alexander
 Producing formation. Arbuckle Lime Depth to top. 3869 Bottom. 3899 Total Depth of Well. 3899 Feet.
 Show depth and thickness of all water, oil and gas formations.

OIL, GAS OR WATER RECORDS

CASING RECORD

Formation	Content	From	To	Size	Put In	Pulled Out
				8-5/8	70	None
				5 1/2	3870	3269

Describe in detail the manner in which the well was plugged, indicating where the mud fluid was placed and the method or methods used in
 introducing it into the hole. If cement or other plugs were used, state the character of same and depth placed, from.....feet to
feet for each plug set.
 Filled hole with mud from 3899 to 3876 cement plug from 3876 to 3861
 Filled with mud to 250 ft where permanent bridge was put in with rock & cement to 235
 Mud to 14 ft & cement to 8 & mud to bottom of cellar & cement cap in bottom of cellar
 Cement was placed in well with dump bailer.

PLUGGING
 FILE NO. 12-9-2224
 BOOK PAGE 29 LINE 16

11-1-41

(If additional description is necessary, use BACK of this sheet)

Correspondence regarding this well should be addressed to. Sharon Drilling Co.
 Address. 352 N. Broadway, Wichita, Kansas.

STATE OF Kansas, COUNTY OF Sedgwick, ss.

(employee of owner) or (owner or operator) of the above-described well,
 being first duly sworn on oath, says: That I have knowledge of the facts, statements, and matters herein contained and the log of the above-
 described well as filed and that the same are true and correct. So help me God

(Signature) *A. Leon Derby*

(Address)

SUBSCRIBED AND SWORN to before me this 28th day of February, 1941

My commission expires. *Sept - 18 - 1941*

Notary Public.

15-065-00023-00-00

COMPANY: Ewers-Simpson Et Al
 Farm: Bundy #1
 Location: C SW $\frac{1}{4}$ SW $\frac{1}{4}$ Sec.12, Twp.9S, R.22W Pipe: 8 $\frac{1}{2}$ " - 80 Ft.
 Graham County, Kansas 5 $\frac{1}{2}$ " - 3871 Ft.
 Commenced: Jan. 2, 1941
 Completed: Feb. 17, 1941 INITIAL POTENTIAL: Dry

	<u>L</u>	<u>O</u>	<u>G</u>	
Sod & Surface				40
Shale				650
Shale				770
Sand				825
Sand & Shale				1016
Shale				1049
Sand & Shale				1138
Shale & Shells				1260
Sand				1275
Shale Red Bed				1325
Sand				1340
Sand, Shale & Shells				1420
Conglomerate				1465
Shale & Shells				1555
Shale & Red Bed				1600
Red Bed				1660
Red Rock, Shale & Shells				1750
Shale & Red Rock				1817
Anhydrite				1843
Shale & Shells				1895
Red Rock & Shale				1925
Shale & Shells				1970
Shale				2000
Shale & Red Rock				2030
Shale				2140
Broken Lime				2535
Sharp Lime				2610
Lime				2660
Lime, Shells & Shale				2700
Lime				2720
Broken Lime				2745
Shale				2765
Lime				2805
Shale				2810
Sandy Lime				2820
Broken Lime				2880
Sharp Lime, Shale & Sand				2940
Lime & Shale				3045
Shale, Lime & Shells				3080
Shale & Shells				3180
Broken Lime				3185
Lime				3210
Broken Lime				3230
Shale & Shells				3330
Lime				3514
Lime & Shale				3540
Lime				3785
Hard Lime				3800
Lime				3840
Shale				3863
Shale & Lime Streak				3869
Dolomite				3876

PLUGGING
 FILE SEC 12-9-R22W
 BOOK PAGE 129-LINE 16-

FEB 26 1941
 STATE CORP. GEOL.
 CONSERV. DIV.
 2-26-41

Top of Arbuckle 3869 Cores 3876 to 3879
 Rough & Soft 3874 $\frac{1}{2}$ -76 Total Depth 3899 in Arbuckle Lime

15-065-00023-00-00

I hereby certify that the above log of the Bundy No. 1 Well located in the C SW $\frac{1}{4}$ SW $\frac{1}{4}$ of Section 12, Township 9S, Range 22W, Graham County, is true and correct to the best of my knowledge and belief.

SHARON DRILLING COMPANY, INC.

SIGNED

A Leon Derby
President

Sworn to and subscribed to before me this 25th Day of Feb., 1941.

M. S. Dadio
(NOTARY PUBLIC)

My Commission Expires April-18-1941

PLUGGING

FILE REC 1219--0224
BOOK PAGE 29 LINE 16

FEB 26 1941
STATE CORP. COM.
CONSERV. DIV.