


STATE CORPORATION COMMISSION

Give All Information Completely
 State Required Affidavit
 Mail or Deliver Report to:
 Conservation Division
 State Corporation Commission
 211 No. Broadway
 Wichita, Kansas

15-065-02987-00-00
WELL PLUGGING RECORD

Graham County, Sec. 12 Twp. 9 Rge. 22 (E) W (W)

NORTH

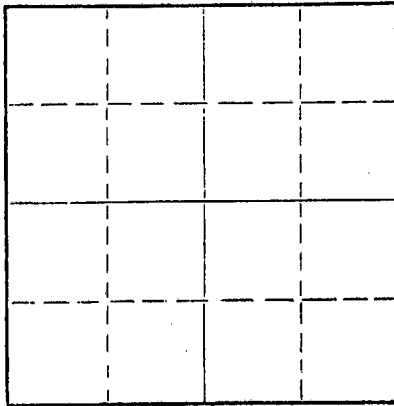

Locate well correctly on above Section Plat

Location as "NE/CNW%SW%" or footage from lines NW NE NE
 Lease Owner North American Oil Corporation
 Lease Name Hedge Well No. 2
 Office Address Paxton, Nebraska
 Character of Well (completed as Oil, Gas or Dry Hole) _____
 Date well completed _____ 19____
 Application for plugging filed _____ 19____
 Application for plugging approved _____ 19____
 Plugging commenced 2-27-62 _____ 19____
 Plugging completed 3-2-62 _____ 19____
 Reason for abandonment of well or producing formation Depleted.

If a producing well is abandoned, date of last production _____ 19____
 Was permission obtained from the Conservation Division or its agents before plugging was commenced? yes

Name of Conservation Agent who supervised plugging of this well Eldon Petty
 Producing formation _____ Depth to top _____ Bottom _____ Total Depth of Well 3864 Feet
 Show depth and thickness of all water, oil and gas formations.

OIL, GAS OR WATER RECORDS

CASING RECORD

FORMATION	CONTENT	FROM	TO	SIZE	PUT IN	PULLED OUT
				8-5/8"	235'	None
				5-1/2"	3859'	2794'

Describe in detail the manner in which the well was plugged, indicating where the mud fluid was placed and the method or methods used in introducing it into the hole. If cement or other plugs were used, state the character of same and depth placed, from _____ feet to _____ feet for each plug set.

Checked hole, pushed plug to 3450',
 ran 30' of sand to 3420' and dumped
 4 sacks of cement @ 3420' with dump
 bailer. Pulled 70 jts. of 5 1/2" casing,
 to 550', pumped 24 sacks of mud @
 550' and pumped in 20 sacks of cement.
 Pumped in 20 more sacks of cement,
 pulled balance of 5 1/2" casing, bailed
 hole to 30' and ran 10 sacks of cement.

RECEIVED
 STATE CORPORATION COMMISSION

MAR 28 1962

PLUGGING COMPLETE.

CONSERVATION DIVISION
 Wichita, Kansas

Name of Plugging Contractor KNIGHT CASING PULLING COMPANY 3-28-62
 Address CHASE, KANSAS

STATE OF KANSAS COUNTY OF RICE, ss.
Noel J. Knight (employee of owner) or (~~owner or operator~~) of the above-described well, being first duly sworn on oath, says: That I have knowledge of the facts, statements, and matters herein contained and the log of the above-described well as filed and that the same are true and correct. So help me God.

(Signature) Noel J. Knight
Chase, Kansas
 (Address)

SUBSCRIBED AND SWORN TO before me this 12th day of March, 1962

My commission expires May 20, 1964 Milton J. Volin Notary Public.

WELL LOG BUREAU—KANSAS GEOLOGICAL SOCIETY

508 East Murdock,

Wichita, Kansas


15-065-02987-00-00

Company- WENTWORTH OIL & DEVEL.
Farm- Hedge No. 2

SEC. 12 T. 9 R. 22W
NW NE NE

Total Depth. 3859'
Comm. 8-13-57 Comp. 8-23- 57
Shot or Treated.
Contractor. Wentworth Oil & Devel.
Issued. 12-17-60

County Graham
KANSAS

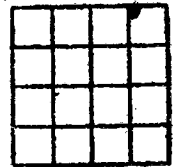

Elevation. 2242'

Production. 2 BOPD

Figures Indicate Bottom of Formations.

COMPLETE DRILLERS LOG NOT AVAILABLE.

TOPS: SCOUT	
Anhydrite	1748
Heebner	3428
Lansing	3468
Arbuckle	3812