


15-065-02239-00.00

STATE OF KANSAS
STATE CORPORATION COMMISSION

Give All Information Completely
Make Required Affidavit
Mail or Deliver Report to:
Conservation Division
State Corporation Commission
800 Bitting Building
Wichita, Kansas

WELL PLUGGING RECORD

NORTH

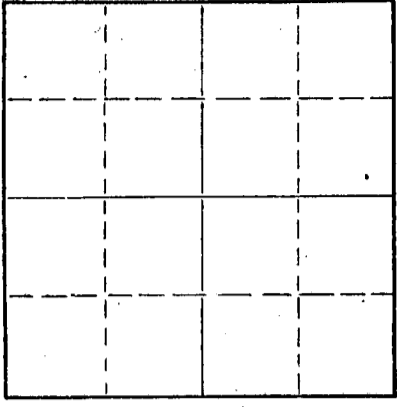

Locate well correctly on above
Section Plat

Graham County. Sec. 11 Twp. 9 Rge. (E) 22 (W)
Location as "NE/CNWxSWx" or footage from lines NW SE SE
Lease Owner Musgrove Petroleum Corporation
Lease Name VAN LOENEN Well No. 2
Office Address 518 Petroleum Building, Wichita, Kansas.
Character of Well (completed as Oil, Gas or Dry Hole) Dry
Date well completed March 4, 1956
Application for plugging filed verbally March 3, 1956
Application for plugging approved verbally March 3, 1956
Plugging commenced March 4, 1956
Plugging completed March 4, 1956
Reason for abandonment of well or producing formation Dry

If a producing well is abandoned, date of last production 19
Was permission obtained from the Conservation Division or its agents before plugging was commenced? verbally - yes.

Name of Conservation Agent who supervised plugging of this well
Producing formation Depth to top Bottom Total Depth of Well 3895 Feet
Show depth and thickness of all water, oil and gas formations.

OIL, GAS OR WATER RECORDS

CASING RECORD

FORMATION	CONTENT	FROM	TO	SIZE	PUT IN	PULLED OUT
				8-5/8"	191	


Describe in detail the manner in which the well was plugged, indicating where the mud fluid was placed and the method or methods used in introducing it into the hole. If cement or other plugs were used, state the character of same and depth placed, from feet to feet for each plug set.

Filled hole with heavy mud to 185'
1st Plug: Set at 185' w/ 1/2 sk hulls & 15 sx cement
Filled hole with heavy mud to 40'
2nd Plug: Set at 40' w/ 1/2 sk hulls & 10 sx cement.

(If additional description is necessary, use BACK of this sheet)
Name of Plugging Contractor Musgrove Petroleum Corporation
Address 518 Petroleum Building, Wichita, Kansas.

STATE OF Kansas COUNTY OF Sedgwick ss.
Gordon L. Koelling, (employee of owner) or (owner/operator) of the above-described well, being first duly sworn on oath, says: That I have knowledge of the facts, statements, and matters herein contained and the log of the above-described well as filed and that the same are true and correct. So help me God.

(Signature) Gordon L. Koelling
518 Petroleum Building, Wichita, Kansas.
(Address)

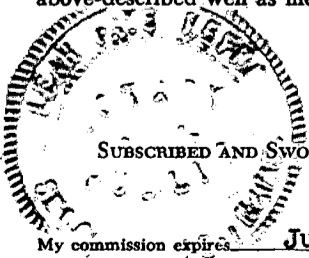

SUBSCRIBED AND SWORN TO before me this 6th day of March, 1956

Reah J. Hays
Notary Public.

PLUGGING
FILE SEC 11 T 9 R 22W
BOOK PAGE 44 LINE 10

RECORDED
STATE CORPORATION COMMISSION
3-8-56
Wichita, Kansas

CONTRACTOR'S WELL LOG

COMPANY: Musgrove Petroleum Corporation
 CONTRACTOR: Musgrove Petroleum Corporation
 FARM: VAN LOENEN #2
 LOCATION: NW SE SE Sec. 11-9-22W
 Graham County, Kansas
 COMMENCED: February 21, 1956
 COMPLETED: March 4, 1956

0	40	Surface soil & clay
40	120	Sand & clay
120	192	Clay, shale & shells
192	1805	Shale & shells
1805	1840	Anhydrite
1840	1855	Anhydrite & shale
1855	2255	Shale & lime streaks
2255	2940	Lime & shale
2940	3002	Lime
3002	3545	Shale & lime
3545	3586	Lime
3586	3635	Lime & shale
3635	3720	Lime
3720	3895	Lime & shale
	3895	Rotary Total Depth

Set 8-5/8" surface pipe at 191' with 135 sacks Posmix.

Dry and Abandoned

ELEVATION: 2307' K. B.
 SAMPLE TOPS: (No Schlumberger)
 Heebner 3497' (-1190)
 Toronto 3522' (-1215)
 Lansing 3538' (-1231)
 Base K. C. 3747' (-1440)
 Arbuckle 3877' (-1570)

STATE OF KANSAS)
) SS
 COUNTY OF SEDGWICK)

I, GORDON L. KOELLING, do hereby certify that the above and foregoing is a true and correct copy of the log of the VAN LOENEN #2, NW SE SE, Section 11-9-22W, Graham County, Kansas, as reflected by the files of the Musgrove Petroleum Corporation.

MUSGROVE PETROLEUM CORPORATION

BY Gordon L. Koelling
 Secretary-Treasurer

Subscribed and sworn to before me, a Notary Public, in and for Sedgwick County, Kansas, this 6th day of March, 1956.

Dean Jaye Neke
 Notary Public

My commission expires June 16, 1959.

38-56

PLUGGING
 FILE SEC 11-9-R-22W
 BOOK PAGE 44 LINE 10