

15-065-00743-00-00


STATE OF KANSAS
STATE CORPORATION COMMISSION

WELL PLUGGING RECORD

Give All Information Completely
Make Required Affidavit
Mail or Deliver Report to:
Conservation Division
State Corporation Commission
800 Bitting Building
Wichita, Kansas

Graham County, Sec. 27 Twp. 9 Rge. 21 (E) W (W)
Location as "NE/CNW/SW" or footage from lines NE NW SW
Lease Owner Bankoff Oil Company
Lease Name Teall Well No. 1
Office Address 823 N. Lewis -- Tulsa, Oklahoma
Character of Well (completed as Oil, Gas or Dry Hole) Dry Hole
Date well completed February 4, 1955 19 55
Application for plugging filed February 4, 19 55
Application for plugging approved February 4, 19 55
Plugging commenced February 4, 19 55
Plugging completed February 4, 19 55
Reason for abandonment of well or producing formation Dry Hole

NORTH

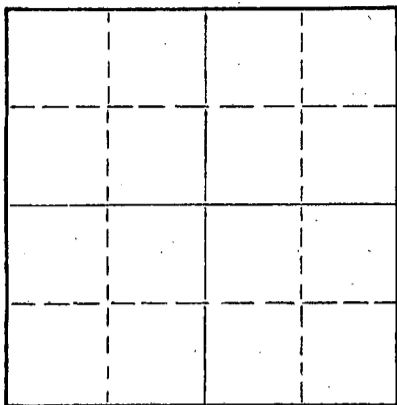

Locate well correctly on above
Section Plat

If a producing well is abandoned, date of last production _____ 19____
Was permission obtained from the Conservation Division or its agents before plugging was commenced? yes

Name of Conservation Agent who supervised plugging of this well Eldon Petty -- Hays, Kansas
Producing formation _____ Depth to top _____ Bottom _____ Total Depth of Well 3921 Feet
Show depth and thickness of all water, oil and gas formations.

OIL, GAS OR WATER RECORDS

CASING RECORD

FORMATION	CONTENT	FROM	TO	SIZE	PUT IN	PULLED OUT
				8 5/8"	158'	None

Describe in detail the manner in which the well was plugged, indicating where the mud fluid was placed and the method or methods used in introducing it into the hole. If cement or other plugs were used, state the character of same and depth placed, from _____ feet to _____ feet for each plug set.

Bottom Plug set at 155' with 15 sacks cement
Top Plug set at 40' with 10 sacks cement

FILED
FEB - 1955
CONSERVATION DIVISION
WICHITA, KANSAS
29-55

(If additional description is necessary, use BACK of this sheet)
Name of Plugging Contractor Anschutz Drilling Co., Inc.
Address 709 Union National Bank Bldg.

STATE OF Kansas, COUNTY OF Sedgwick, ss.
E. G. Koelling (employee of owner) or (owner or operator) of the above-described well, being first duly sworn on oath, says: That I have knowledge of the facts, statements, and matters herein contained and the log of the above-described well as filed and that the same are true and correct. So help me God.

(Signature) E. G. Koelling
709 Union National Bank Bldg.
(Address)

SUBSCRIBED AND SWORN to before me this 8th day of February, 19 55
My commission expires July 28, 1958
Charlaine Barlow
Notary Public.



PLUGGING
FILE SEC. 27, 9 R. 21W
BOOK PAGE 95 LINE 41

DRILLER'S LOG

Bankoff Oil Company
 Teall #1
 NE NW SW
 100' East, which is 330' S of NL - 1090' E of WL
 27-9-21
 Graham County, Kansas

<u>TO</u>	<u>FROM</u>	
0	60	Surface Soil & Shale
60	80	Sand
80	165	Shale & Shells
165	950	Shale & Shells
950	1245	Shale & Sand Streaks
1245	1350	Shale
1350	1550	Sand
1550	1798	Red Bed
1798	1840	Anhydrite
1840	2380	Shale & Shells
2380	2500	Shale & Lime
2500	2575	Lime Sandy
2575	2710	Lime & Shale
2710	2845	Shale & Lime
2845	2955	Lime
2955	3075	Shale & Lime
3075	3270	Lime
3270	3370	Lime & Shale
3370	3705	Lime
3705	3750	Lime & Shale
3750	3799	Shale & Lime
3799	3906	Lime & Shale
3906	3911	Shale & Lime
3911	3921	Arbuckle
	3921	ROTARY TOTAL DEPTH

COMMENCED: 1-25-55
 COMPLETED: 2-4-55

CASING RECORD:

Set 158' of 8 5/8" with 100 sacks cement.

D & A

STATE OF KANSAS)
) SS
 COUNTY OF SEDGWICK)

2-9-55

I hereby affirm that the above and foregoing is a true and correct copy of the log of the Teall #1 located NE NW SW, 100' East, which is 330' S of NL - 1090' E of WL of Section 27-9-21, Graham County, Kansas.

ANSCHUTZ DRILLING CO., INC.

BY:

E. G. Koelling
 E. G. Koelling

Subscribed and sworn to before me this 8th day of February, 1955.

Charlene Barkow
 Notary Public

My Commission Expires: July 28, 1958.

PLUGGING
 FILE SEC 27 T 9 R 21 W
 BOOK PAGE 95 LINE 41

