

STATE OF KANSAS  
STATE CORPORATION COMMISSION

WELL PLUGGING RECORD

Give All Information Completely  
Make Required Affidavit  
Mail or Deliver Report to  
Conservation Division  
State Corporation Comm.  
245 North Water  
Wichita, KS 67202

Rooks County. Sec. 31 Twp. 10 Rge. 19 E/W  
Location as "NE/CNW $\frac{1}{4}$ SW $\frac{1}{4}$ " or footage from lines "330S NW NW NE"

Lease Owner J V Oil Operations  
Lease Name Tomasheck Well No. 1


Office Address 1310 E. 22 St Hays, Kansas 67601  
Character of Well (Completed as Oil, Gas or Dry Hole) dry hole

Date Well completed 3-27-83 19  
Application for plugging filed 3-27-83 19  
Application for plugging approved 3-27-83 19  
Plugging commenced 1:00 A. M. 3-27-83 19  
Plugging completed 6:15 A.M. 3-27-83 19  
Reason for abandonment of well or producing formation dry

If a producing well is abandoned, date of last production 19

Was permission obtained from the Conservation Division or its agents before plugging was commenced? yes

Name of Conservation Agent who supervised plugging of this well Marion Schmidt  
Producing formation \_\_\_\_\_ Depth to top \_\_\_\_\_ Bottom \_\_\_\_\_ Total Depth of Well \_\_\_\_\_  
Show depth and thickness of all water, oil and gas formations.

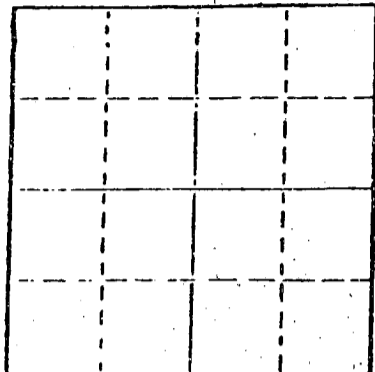

Locate well correctly on above Section Plat

OIL, GAS OR WATER RECORDS

CASING RECORD

FORMATION	CONTENT	FROM	TO	SIZE	PUT IN	PULLED OUT

Describe in detail the manner in which the well was plugged, indicating where the mud fluid was placed and the method or methods used in introducing it into the hold. If cement or other plugs were used, state the character of same and depth placed, from \_\_\_\_\_ feet to \_\_\_\_\_ feet for each plug set.

- 1st plug 3720 with 20 sacks
- 2nd plug 1620 with 20 sacks
- 3rd plug 960 with 100 sacks
- 4th plug 270 with 40 sacks
- 5th plug 40 with 10 sacks
- 10 sacks in rat hole
- Total 200 sacks 50/50 poz 6% gel 3% cc


(If additional description is necessary, use BACK of this sheet)

Name of Plugging Contractor Lawbanco Drilling, Inc.  
Box 289 Natoma, Kansas 67651

STATE OF Kansas COUNTY OF Osborne, ss.  
R. L. Finney (employee of owner) or (owner or operator)  
of the above-described well, being first duly sworn on oath, says: That I have knowledge of the facts, statements, and matters herein contained and the log of the above-described well as filed and that the same are true and correct. So help me God.

(Signature) R L Finney  
3703 JP Drive Hays, Kansas 67601  
(Address)

SUBSCRIBED AND SWORN TO before me this 12th day of April, 19 83

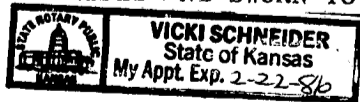

Vicki Schneider  
Vicki Schneider  
STATE CORPORATION COMMISSION Notary Public.

My commission expires February 22, 1986

APR 14 1983  
04-14-1983  
CONSERVATION DIVISION  
Wichita, Kansas