


15-163-20551-00-00

STATE OF KANSAS  
STATE CORPORATION COMMISSION  
CONSERVATION DIVISION  
P. O. BOX 17027  
WICHITA, KANSAS 67217

FORM CP-4

WELL PLUGGING RECORD

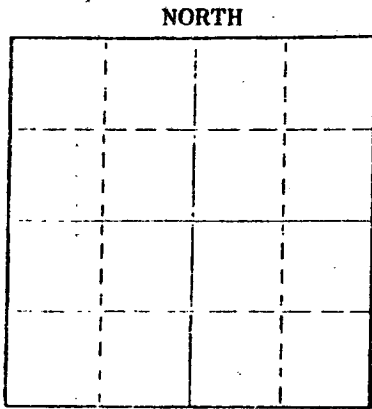

Locate well correctly on above  
Section Plat

Rooks \_\_\_\_\_ County. Sec. 33 Twp. 10 Rge. 19 (E) W (W)  
Location as "NE/CNW&SW¼" or footage from lines. NE NW NW  
Lease Owner Dreiling Oil, Inc.  
Lease Name Armbrister Well No. 1  
Office Address Rt. #2, Victoria, KS 67671  
Character of Well (completed as Oil, Gas or Dry Hole) Dry Hole  
Date well completed 12-10 19 74  
Application for plugging filed 12-10 19 74  
Application for plugging approved 12-10 19 74  
Plugging commenced 12-10 19 74  
Plugging completed 12-10 19 74  
Reason for abandonment of well or producing formation Dry Hole

If a producing well is abandoned, date of last production \_\_\_\_\_ 19 \_\_\_\_  
Was permission obtained from the Conservation Division or its agents before plugging was commenced? yes

Name of Conservation Agent who supervised plugging of this well Leo Massey, Hays, KS 67601  
Producing formation \_\_\_\_\_ Depth to top \_\_\_\_\_ Bottom \_\_\_\_\_ Total Depth of Well \_\_\_\_\_ Feet  
Show depth and thickness of all water, oil and gas formations.

OIL, GAS OR WATER RECORDS.

CASING RECORD

FORMATION	CONTENT	FROM	TO	SIZE	PUT IN	PULLED OUT
	Surface Pipe			8 5/8"	151'	

Describe in detail the manner in which the well was plugged, indicating where the mud fluid was placed and the method or methods used in introducing it into the hole. If cement or other plugs were used, state the character of same and depth placed, from \_\_\_\_\_ feet to \_\_\_\_\_ feet for each plug set.

1st plug was set @ 650' w/70 cu. ft. cement  
2nd plug was set @ 158' w/20 cu. ft. cement  
3rd plug was set @ 40' w/10 cu. ft. cement.

RECEIVED  
STATE CORPORATION COMMISSION  
DEC 19 1974  
12-19-1974  
CONSERVATION DIVISION  
Wichita, Kansas

(If additional description is necessary, use BACK of this sheet)  
Name of Plugging Contractor Dreiling Oil, Inc.  
Address Rt. #2, Victoria, KS 67671

STATE OF KANSAS COUNTY OF ELLIS SS.

I, Joseph A. Hess, Sec.-Treas. of Drlg. Contr. of the above-described well, being first duly sworn on oath, says: That I have knowledge of the facts, statements, and matters herein contained and the log of the above-described well as filed and that the same are true and correct. So help me God.

(Signature) Joseph A. Hess  
JOSEPH A. HESS, Hays, KS 67601  
(Address)

Subscribed and sworn to before me this 17th day of December, 19 74



September 13, 1976  
Cecilia Basgall  
Notary Public.

