

WELL PLUGGING RECORD

Give All Information Completely
Make Required Affidavit
Mail or Deliver Report to:
Conservation Division
State Corporation Commission
211 No. Broadway
Wichita, Kansas

ROOKS County. Sec. 6 Twp. 10 Rge. 20 (E) 20(W)

Location as "NE/CNW%SW%" or footage from lines SW NW NW

Lease Owner D. G. HANSEN

Lease Name WOLF Well No. 4

Office Address LOGAN, KANSAS

Character of Well (completed as Oil, Gas or Dry Hole) DRY HOLE

Date well completed JUNE 26 19 56

Application for plugging filed JUNE 26 19 56

Application for plugging approved JUNE 26 19 56


Plugging commenced JUNE 27 19 56

Plugging completed JUNE 27 19 56

Reason for abandonment of well or producing formation TOO LOW STRUCTUALLY

If a producing well is abandoned, date of last production _____ 19 _____

Was permission obtained from the Conservation Division or its agents before plugging was commenced? YES

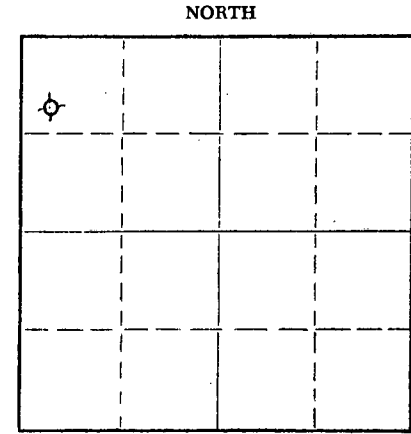

Locate well correctly on above Section Plat

Name of Conservation Agent who supervised plugging of this well ELDON PETTY, HAYS, KANSAS

Producing formation _____ Depth to top _____ Bottom _____ Total Depth of Well 3871 Feet

Show depth and thickness of all water, oil and gas formations.

OIL, GAS OR WATER RECORDS

CASING RECORD

FORMATION	CONTENT	FROM	TO	SIZE	PUT IN	PULLED OUT
				8-5/8"	162'	none

Describe in detail the manner in which the well was plugged, indicating where the mud fluid was placed and the method or methods used in introducing it into the hole. If cement or other plugs were used, state the character of same and depth placed, from _____ feet to _____ feet for each plug set.

Filled hole with mud up to 155'. Set plug.
Put in 1/2 sack Hulls and 15 sacks cement.
Filled with heavy mud up to 40'. Set plug.
Filled to top with 1/2 sack Hulls and 10 sacks cement.

RECEIVED
STATE CORPORATION COMMISSION

JUN 30 1956
06-30-1956
CONSERVATION DIVISION
WICHITA, KANSAS

(If additional description is necessary, use BACK of this sheet)

Name of Plugging Contractor C-G DRILLING CO.

Address 107 RULE BLDG., WICHITA, KANSAS

STATE OF KANSAS, COUNTY OF SEDGWICK, ss.

G. F. Galloway (employee of owner) or (owner or operator) of the above-described well, being first duly sworn on oath, says: That I have knowledge of the facts, statements, and matters herein contained and the log of the above-described well as filed and that the same are true and correct. So help me God.


(Signature) G. F. Galloway

107 Rule Bldg.
(Address)

SUBSCRIBED AND SWORN TO before me this 29th day of June, 1956

My commission expires May 20, 1959

Vicky Jacobs
Notary Public.

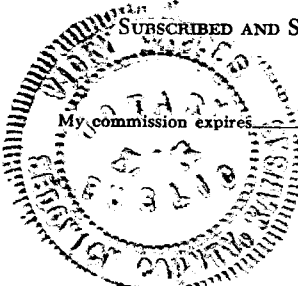

PLUGGING
FILE SEC 6 T 10 R 20W
BOOK PAGE 76 LINE 11

15-163-03075-00-00

CONTRACTOR'S WELL LOG

OPERATOR D. G. HANSEN WELLNAME WOLF #4

LOCATION SW NW NW Section 6-10-20W RIG NO. 1

COUNTY ROOKS STATE KANSAS

COMMENCEMENT DATE JUNE 17, 1956 COMPLETION DATE _____

LOG OF WELL

Elevation 2279 Kelley Bushing.
All measurements taken from top of rotary bushing.

FROM	TO	FORMATION	DEVIATION FROM VERTICAL	REMARKS
0	162	Surface Soil		
162	1245	Shale-Sand		
1245	1500	Sand		
1500	1772	Red Bed		
1772	1812	Anhydrite		
1812	1830	Sand		
1830	2140	Lime-Shale		
2140	2295	Lime-Shale		
2295	2430	Lime-Shale		
2430	2575	Lime-Shale	0° - 2500	
2575	2690	Lime-Shale		
2690	2815	Lime-Shale	0° - 2750	
2815	2895	Lime-Shale	-	
2895	2990	Lime-Shale		
2990	3150	Lime-Shale	0° - 3000	
3150	3285	Lime-Shale	0° - 3250	
3285	3383	Lime-Shale	-	
3383	3445	Lime-Shale		
3445	3514	Lime-Shale	0° 3500	
3514	3625	Lime-Shale	-	
3625	3647	Lime-Shale		
3647	3689	Lime-Shale		DST 3637-3647
3689	3785	Lime-Shale	0° - 3750	
3785	3825	Lime-Shale	-	
3825	3871	Lime-Shale		DST 3866-3871

CASING LEFT IN HOLE AFTER COMPLETION

Set 162' of 8 5/8" OD Surface Casing.

STATE OF KANSAS, COUNTY OF SEDGWICK) SS.

The undersigned hereby certifies that to the best of his knowledge and belief, the above facts are true and correct.

C-G DRILLING CO.

By G. F. Galloway
G. F. Galloway

Subscribed and sworn to before me this 29th day of June, 1956.

My commission expires:
May 20, 1959

Vicky Jacobs
Vicky Jacobs, Notary Public

PLUGGING
FILE SEC 6 T 10 R 20W
BOOK PAGE 75 LINE 11