

15-163-03074-00-00

WELL PLUGGING RECORD

Give All Information Completely
Make Required Affidavit
Mail or Deliver Report to:
Conservation Division
State Corporation Commission
800 Bitting Building
Wichita, Kansas

Rooks County, Sec. 6 Twp. 10 Rge. 20 (E) W (W)

Location as "NE/CNW/SW" or footage from lines NE SW NW

Lease Owner D. G. Hansen

Lease Name Tucker Well No. 2

Office Address Logan, Kansas

Character of Well (completed as Oil, Gas or Dry Hole) Dry Hole

Date well completed 9-4 1954

Application for plugging filed 9-4 1954

Application for plugging approved 9-4 1954


Plugging commenced 9-4 1954

Plugging completed 9-4 1954

Reason for abandonment of well or producing formation Too low structurally

If a producing well is abandoned, date of last production -- 19---

Was permission obtained from the Conservation Division or its agents before plugging was commenced? Yes

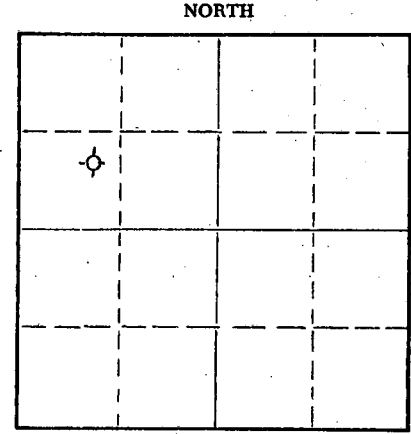

Locate well correctly on above Section Plat

Name of Conservation Agent who supervised plugging of this well Eldon Petty, Hays, Kansas

Producing formation -- Depth to top -- Bottom -- Total Depth of Well 3896 Feet

Show depth and thickness of all water, oil and gas formations.

OIL, GAS OR WATER RECORDS

CASING RECORD

FORMATION	CONTENT	FROM	TO	SIZE	PUT IN	PULLED OUT
				8-5/8"	165.84'	None

Describe in detail the manner in which the well was plugged, indicating where the mud fluid was placed and the method or methods used in introducing it into the hole. If cement or other plugs were used, state the character of same and depth placed, from --- feet to --- feet for each plug set.

Filled hole with mud to 160'; set plug:
1/2 sack hulls, 15 sacks cement. Filled
hole with mud to 40'; set plug then filled
to top with 10 sacks cement, 1/2 sack hulls.

(If additional description is necessary, use BACK of this sheet)
Name of Plugging Contractor C-G Drilling Co.
Address 107 Rule Building, Wichita, Kansas

STATE OF KANSAS COUNTY OF SEDGWICK, ss.
Vicky, Jacobs (employee of owner) or (~~owner~~ operator) of the above-described well, being first duly sworn on oath, says: That I have knowledge of the facts, statements, and matters herein contained and the log of the above-described well as filed and that the same are true and correct. So help me God.

(Signature) Vicky Jacobs
Office Manager
107 Rule Building, Wichita, Kansas
(Address)

SUBSCRIBED AND SWORN to before me this 7th day of September, 1954
My commission expires June 17, 1957



Barbara Donaldson
RECEIVED
STATE CORPORATION COMMISSION
Notary Public.

PLUGGING
FILE SEC 6 T 10 R 20W
BOOK PAGE 61 LINE 43

SEP - 3 1954
09-08-1954
CONSERVATION DIVISION
Wichita, Kansas

15-163-03074-00-00

CONTRACTOR'S WELL LOG

OPERATOR D. G. Hansen FARM NAME Tucker #2
 LOCATION NE SW NW, Section 6-10-20W
 POOL NAME Palco COUNTY Rooks STATE Kansas
 COMMENCEMENT DATE August 27, 1954 COMPLETION DATE September 4, 1954

LOG OF WELL

Elevation: 2286 R.B.
 All measurements from the top of rotary bushing.

FROM	TO	FORMATION	DEVIATION FROM VERTICAL	REMARKS:
0	165	Shale-Sand		
165	1238	Shale-Sand		
1238	1290	Shale		
1290	1510	Sand		
1510	1777	Red Bed		
1777	1800	Anhydrite	0° - 1500'	
1800	1815	Anhydrite		
1815	2250	Shale-Shells	0° - 2000'	
2250	2471	Shale-Shells		
2471	2660	Lime-Shale	0° - 2500'	
2660	2800	Lime-Shale		
2800	2915	Lime-Shale		
2915	3040	Lime-Shale	0° - 3000'	
3040	3200	Lime-Shale		
3200	3340	Lime-Shale		
3340	3400	Lime-Shale		
3400	3500	Lime-Shale	0° - 3500'	
3500	3575	Lime-Shale		
3575	3635	Lime-Shale		
3635	3690	Lime-Shale		
3690	3735	Lime-Shale		
3735	3790	Lime-Shale		
3790	3848	Lime-Shale		
3848	3890	Lime-Shale		
3890	3896	Lime-Shale		

CASING LEFT IN HOLE AFTER COMPLETION

Ran 165.84' of 8-5/8" casing.
 STATE OF KANSAS, COUNTY OF SEDGWICK) ss.

The undersigned certifies that to the best of her knowledge and belief, the above facts are true and correct.

C-G DRILLING CO.

By *Vicky Jacobs*
 Office Manager

Subscribed and sworn to before me this 7th day of September, 1954.

My commission expires:
 6/17/57

Barbara Donaldson
 Notary Public



PLUGGING
 FILE SEC 6 T10 R 20W
 BOOK PAGE 61 LINE 43

09-08-1954