


15-163-30329-00-01

FORM CP-4

STATE OF KANSAS
STATE CORPORATION COMMISSION
CONSERVATION DIVISION
P. O. BOX 17027
WICHITA, KANSAS 67217

WELL PLUGGING RECORD

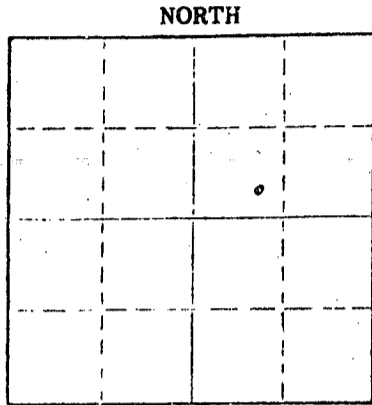

Locate well correctly on above Section Plat

Rocks _____ County. Sec. 6 Twp. 10 Rge. 20 (E) _____ (W) _____
Location as "NE/CNW/SW" or footage from lines. C SE SW NE
Lease Owner Gulf Oil Corporation
Lease Name Hinkhouse #5 Well No. _____
Office Address Plainville, Kansas 67663
Character of Well (completed as Oil, Gas or Dry Hole) O. I
Date well completed 1-9 19 53
Application for plugging filed 11-18 19 74
Application for plugging approved 11-21 19 74
Plugging commenced 3/19/75 (Renew) 3-6-75 19 _____
Plugging completed 3/24/75 19 _____
Reason for abandonment of well or producing formation depleted.

If a producing well is abandoned, date of last production May 19 69
Was permission obtained from the Conservation Division or its agents before plugging was commenced? yes

Name of Conservation Agent who supervised plugging of this well Massey
Producing formation _____ Depth to top _____ Bottom _____ Total Depth of Well 3838 Feet
Show depth and thickness of all water, oil and gas formations.

OIL, GAS OR WATER RECORDS

CASING RECORD

FORMATION	CONTENT	FROM	TO	SIZE	PUT IN	PULLED OUT
				8-5/8	1777	none
				5 1/2"	3836	2138'

Describe in detail the manner in which the well was plugged, indicating where the mud fluid was placed and the method or methods used in introducing it into the hole. If cement or other plugs were used, state the character of same and depth placed, from _____ feet to _____ feet for each plug set.

Checked hole, sanded to 3700' and ran 3 sacks cement. Pushed plug to 3500' and ran sand and 4 sacks cement. Shot pipe at 3106', pulled pipe into. Fished pipe, pulled pipe into again, pulled 64 joints. Set rock bridge from 700 to 475' and ran 3 yards ready mix. Set bridge from 225 to 200' and ran 3 yards ready mix.

PLUGGING COMPLETE.

(If additional description is necessary, use BACK of this sheet)

Name of Plugging Contractor KELSO CASING PULLING
Address CHASE, KANSAS

STATE OF KANSAS COUNTY OF RICE
R. Darrell Kelso ss.

(employee of owner) or (owner or operator) of the above-described well, being first duly sworn on oath, says: That I have knowledge of the facts, statements, and matters herein contained and the log of the above-described well as filed and that the same are true and correct. So help me God.

(Signature) R. Darrell Kelso

Chase, Kansas

(Address)

SUBSCRIBED AND SWORN TO before me this 31st day of March, 19 75

My commission expires _____



RECEIVED
STATE CORPORATION COMMISSION

APR 17 1975
04-17-1975
CONSERVATION DIVISION
Wichita, Kansas

15-163-30329-00-01

RECEIVED
STATE CORPORATION COMMISSION
NOV 21 1974
11-21-1974
CONSERVATION DIVISION
Wichita, Kansas

DRILLER'S LOG

Company: Gulf Oil Corporation.

CSE SW NE
Sec 6 Twp. 10S Rge 20W

Farm: Hinkhouse Well No. 5

County: Rooks, Kansas

Total Depth: 3838'
Comm: 12-29-52; Comp: 1-9-53
Contractor: Glenn W. Peel
Casing: 8 5/8" 1786' Cem.
5 1/2" 3836' Cem.

Elevation:
Production:

Figures Below Indicate bottom of formation

Surface clay and sand	0-	145
Sand and shale		350
Shale and shells		920
Sand and shale		1080
Shale and shells		1220
Sand and shale		1730
Red bed and shells		1780
Anhydrite		1815
Shale and shells		2235
Shale		2320
Shale and shells		2495
Lime and shale		2615
Shale W/ lime streaks		2740
Shale and lime		2825
Lime and shale		2970
Lime W/shale streaks		3075
Lime and shale		3305
Lime		3790
Conglomerate		3838
Total Depth		3838

RECEIVED
STATE CORPORATION COMMISSION
NOV 18 1974
11-18-1974
CONSERVATION DIVISION
Wichita, Kansas

This is to certify that the above information is, to the best of our knowledge, true and correct.

GLENN W. PEEL

BY: Glenn W. Peel

SUBSCRIBED AND SWORN TO BEFORE me this 16th day of Jan, 1953

My commission expires June 4, 1955

Marian M. Herbert
Notary Public