

15-163-20574-00-00

STATE OF KANSAS  
STATE CORPORATION COMMISSION


Form CP-4

Give All Information Completely  
Make Required Affidavit  
Mail or Deliver Report to:  
Conservation Division  
State Corporation Commission  
P. O. Box 17027

WELL PLUGGING RECORD

Wichita, Kansas 67217  
NORTH

ROOKS County, Sec. 6 Twp. 10S Rge. (E) 20 (W)  
Location as "NE/CNW/SW" or footage from lines SE SE NW  
Lease Owner DANE G HANSEN TRUST  
Lease Name HOLMES Well No. 4  
Office Address LOGAN, KANSAS 67646  
Character of Well (completed as Oil, Gas or Dry Hole)  
Date well completed AUGUST 17 1975  
Application for plugging filed AUGUST 17 1975  
Application for plugging approved AUGUST 17 1975  
Plugging commenced AUGUST 17 1975  
Plugging completed AUGUST 17 1975  
Reason for abandonment of well or producing formation TOO LOW STRUCTURALLY

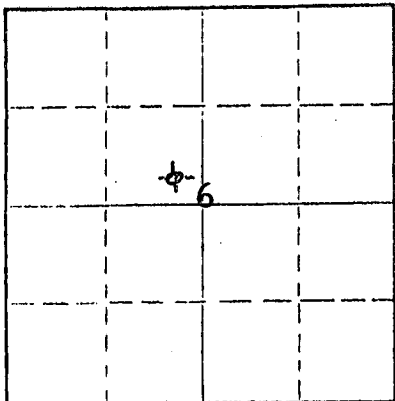

Locate well correctly on above  
Section Plat

If a producing well is abandoned, date of last production 19  
Was permission obtained from the Conservation Division or its agents before plugging was commenced? YES

Name of Conservation Agent who supervised plugging of this well LEO F MASSEY, HAYS, KANSAS  
Producing formation Depth to top Bottom Total Depth of Well 3874 Feet  
Show depth and thickness of all water, oil and gas formations.

OIL, GAS OR WATER RECORDS

CASING RECORD

FORMATION	CONTENT	FROM	TO	SIZE	PUT IN	PULLED OUT
				8 5/8"	188.59'	None

Describe in detail the manner in which the well was plugged, indicating where the mud fluid was placed and the method or methods used in introducing it into the hole. If cement or other plugs were used, state the character of same and depth placed, from feet to feet for each plug set.

FILLED WITH HEAVY MUD TO 660'. SET  
PLUG. PUT IN 70 SACKS CEMENT. FILLED  
WITH HEAVY MUD TO 185'. SET PLUG.  
PUT IN 20 SACKS CEMENT. FILLED WITH  
HEAVY MUD TO 40'. SET PLUG. FILLED  
TO TOP WITH 1 SACK HULLS & 10 SACKS  
CEMENT. (50-50 POZMIX 6% GEL).

RECEIVED  
STATE CORPORATION COMMISSION

AUG 20 1975  
08-28-1975  
CONSERVATION DIVISION  
Wichita, Kansas

(If additional description is necessary, use BACK of this sheet)  
Name of Plugging Contractor C-G DRILLING CO.  
Address 1107 UNION NATIONAL BUILDING, WICHITA, KANSAS 67202

STATE OF KANSAS, COUNTY OF SEDGWICK, ss.  
G. F. Galloway (employee of owner) or (owner or operator) of the above-described

well, being first duly sworn on oath, says: That I have knowledge of the facts, statements, and matters herein contained and the log of the above-described well as filed and that the same are true and correct. So help me God.

(Signature) G. F. Galloway  
G. F. Galloway  
1107 Union National Bldg., Wichita, Ks.  
(Address)

Subscribed and sworn to before me this 22nd day of August, 1975



Phyllis Buchanan  
Notary Public.

My commission expires December 7, 1975

**KANSAS DRILLERS LOG**


API No. 15 - 1163 - 20574-00-00  
 County Number

S. 6 T. 10 R. 20W <sup>E</sup>/<sub>W</sub>

Loc. SE SE NW

County ROOKS

640 Acres  
N

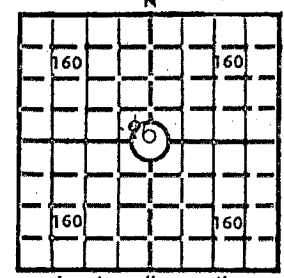

Locate well correctly

Elev.: Gr. \_\_\_\_\_

DF \_\_\_\_\_ KB 2262

Operator <b>DANE G HANSEN TRUST</b>	
Address <b>LOGAN, KANSAS 67646</b>	
Well No. <b>4</b>	Lease Name <b>HOLMES</b>
Footage Location <b>330</b> feet from <b>XX</b> (S) line <b>330</b> feet from (E) <b>XX</b> line	
Principal Contractor <b>C-G DRILLING CO.</b>	Geologist <b>JERRY JESPERSEN</b>
Spud Date <b>AUGUST 9, 1975</b>	Total Depth <b>3874'</b>
Date Completed <b>AUGUST 17, 1975</b>	P.B.T.D.
Oil Purchaser	

**CASING RECORD**

Report of all strings set — surface, intermediate, production, etc.

Purpose of string	Size hole drilled	Size casing set (in O.D.)	Weight lbs/ft.	Setting depth	Type cement	Sacks	Type and percent additives
SURFACE	12 1/4"	8 5/8"	20&28#	188.59	COMMON	125	2% GEL 3% CA CL

**LINER RECORD**

**PERFORATION RECORD**

Top, ft.	Bottom, ft.	Sacks cement	Shots per ft.	Size & type	Depth interval

**TUBING RECORD**

Size	Setting depth	Packer set at

**ACID, FRACTURE, SHOT, CEMENT SQUEEZE RECORD**

Amount and kind of material used	Depth interval treated

RECEIVED  
 STATE CORPORATION COMMISSION  
 AUG 28 1975  
 DB-28-1975  
 CONSERVATION DIVISION  
 WICHITA, KANSAS

**INITIAL PRODUCTION**

Date of first production	Producing method (flowing, pumping, gas lift, etc.)			
RATE OF PRODUCTION PER 24 HOURS	Oil	Gas	Water	Gas-oil ratio
	bbls.	MCF	bbls.	CFPB
Disposition of gas (vented, used on lease or sold)			Producing interval (s)	

INSTRUCTIONS: As provided in KCC Rule 82-2-125, within 90 days after completion of a well, one completed copy of this Drillers Log shall be transmitted to the State Geological Survey of Kansas, 4150 Monroe Street, Wichita, Kansas 67209. Copies of this form are available from the Conservation Division, State Corporation Commission, 3830 So. Meridian (P.O. Box 17027), Wichita, Kansas 66217. Phone AC 316-522-2206. If confidential custody is desired, please note Rule 82-2-125. Drillers Logs will be on open file in the Oil and Gas Division, State Geological Survey of Kansas, Lawrence, Kansas 66044.

DESIGNATE  
 DRY HOLE, SWD.V., ETC.:  
 DRY HOLE

DANE G HANSEN TRUST

Well No.  
 4

Lease Name  
 HOLMES

S 6 T 10 R 20 <sup>E</sup>/<sub>W</sub>

**WELL LOG**

Show all important zones of porosity and contents thereof; cored intervals, and all drill-stem tests, including depth interval tested, cushion used, time tool open, flowing and shut-in pressures, and recoveries.

SHOW GEOLOGICAL MARKERS, LOGS RUN, OR OTHER DESCRIPTIVE INFORMATION.

FORMATION DESCRIPTION, CONTENTS, ETC.	TOP	BOTTOM	NAME	DEPTH
SHALE	0	1100		
SAND	1100	1508		
SHALE	1508	1767		
ANHYDRITE	1767	1807		
SHALE & SHELLS	1807	2135		
SHALE & LIME	2135	2240		
SHALE & SHELLS	2240	2300		
LIME & SHALE	2300	3470		
LIME	3470	3874		
RTD		3874		
DST #1 3575'3638' OPEN 30-SI 30-OPEN 30-SI 30 REC 185' MUD IBHP 415# FBHP 405# IFP 69# FFP 184#				

USE ADDITIONAL SHEETS, IF NECESSARY, TO COMPLETE WELL RECORD.

Date Received

*Phyllis Buchanan*

Phyllis Buchanan  
 Office Manager

Title

AUGUST 22, 1975

Date