

WELL PLUGGING RECORD

Give All Information Completely
Make Required Affidavit
Mail or Deliver Report to:
Conservation Division
State Corporation Commission
211 No. Broadway
Wichita, Kansas

Rooks County, Sec. 6 Twp. 10S Rge. (E) 20 (W)

Location as "NE/CNW/SW" or footage from lines 1650' NSL & 1600' WEL

Lease Owner Gulf Oil Corporation

Lease Name F. Hinkhouse Well No. 4

Office Address Box 661, Tulsa, Oklahoma

Character of Well (completed as Oil, Gas or Dry Hole) Oil

Date well completed 10-22 19 52

Application for plugging filed 6-10 19 58

Application for plugging approved * 19


Plugging commenced 7-3 19 58

Plugging completed 7-6 19 58

Reason for abandonment of well or producing formation Well operating below its economic limit.

If a producing well is abandoned, date of last production 4-15 19 58

Was permission obtained from the Conservation Division or its agents before plugging was commenced? Yes

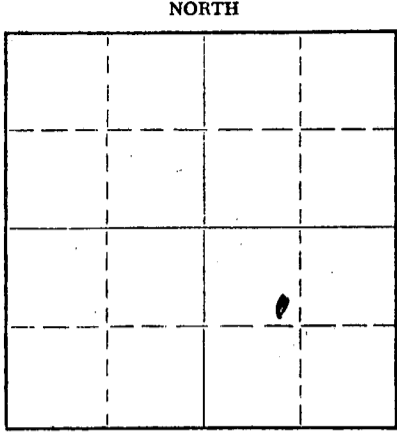

Locate well correctly on above Section Plat

Name of Conservation Agent who supervised plugging of this well *

Producing formation Arbuckle Depth to top 3829' Bottom 3855' Total Depth of Well 3855 Feet

Show depth and thickness of all water, oil and gas formations.

OIL, GAS OR WATER RECORDS

CASING RECORD

FORMATION	CONTENT	FROM	TO	SIZE	PUT IN	PULLED OUT
				8-5/8"	1775'	0
				6"	3830'	3415'

Describe in detail the manner in which the well was plugged, indicating where the mud fluid was placed and the method or methods used in introducing it into the hole. If cement or other plugs were used, state the character of same and depth placed, from _____ feet to _____ feet for each plug set.

Filled hole with sand to 3816' and dumped 5 sx. cement. Filled with mud to 400' and spotted 20 sx. cement thru casing. Filled with mud to 150' and spotted 20 sx. cement thru casing. Filled with mud and capped with 10 sx. cement, filling hole into cellar.

* Well sold for salvage to Degen Pipe & Supply Co., Box 107, Red Fork Station, Tulsa, Oklahoma. Date of State authorization to plug and plugging inspector are unknown.

(If additional description is necessary, use BACK of this sheet)

Name of Plugging Contractor Bert Self Casing Pulling Company

Address RR #4, Hutchinson, Kansas

STATE OF Kansas, COUNTY OF Sedgwick, ss.

Thomas A. Trax (employee of owner) or (owner or operator) of the above-described well, being first duly sworn on oath, says: That I have knowledge of the facts, statements, and matters herein contained and the log of the above-described well as filed and that the same are true and correct. So help me God.

(Signature) *Thomas A. Trax*


Box 2233, Wichita, Kansas (Address)

SUBSCRIBED AND SWORN TO before me this 8th day of July, 1958

My commission expires _____

J. W. Garner
Notary Public.

J. W. GARNER, NOTARY PUBLIC

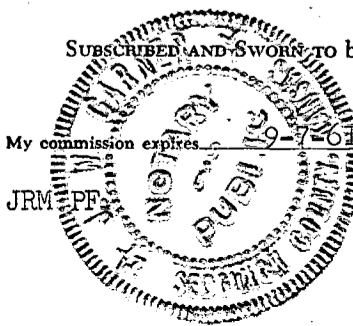

RECEIVED
STATE CORPORATION COMMISSION
07-12-1958
JUL 12 1958

CONSERVATION DIVISION
Kansas

PLUGGING
FILE SEC 6 T 10 R 20W
BOOK PAGE 107 LINE 28

FRANK HINKHOUSE NO. 4
 CENTER SE NW SE SECTION 6-108-20W
 ROOKS COUNTY, KANSAS
 GULF OIL CORPORATION

15-163-03015-00-00

8-5/8" O. D. Casing Cemented at 1775'
~~5-1/2"~~ O. D. Casing Cemented at 3831'
 6"

Drilling Commenced September 29, 1952
 Drilling Completed October 11, 1952

FROM	TO	FORMATION	REMARKS
0'	40'	Sand	
40	480	Sand, gravel & clay	
480	800	Sand, clay & shale	
800	1090	Shale & sand	
1090	1535	Lime & shale	
1535	1767	Red bed	
1767	1785	Anhydrite	
1785	2005	Shale & lime	8-5/8" O. D. Casing Cemented with 725 sacks Portland Cement at 1775'
2005	2470	Lime & shale	
2470	2710	Lime	
2710	2830	Lime & shale	
2830	3135	Shale & lime	
3135	3240	Lime & shale	
3240	3480	Shale & lime	
3480	3535	Lime & shale	
3535	3831	Lime	6" 5-1/2" O. D. Casing Cemented at 3831'
T.D.	3831'		

Drilled deeper with Cable tools to 3855'

Jan

06-12-1958

PLUGGING
 FILE SEC 6 T. 10 R. 20 W.
 BOOK PAGE 107 LINE 28