


WELL PLUGGING RECORD

Give All Information Completely
Make Required Affidavit
Mail or Deliver Report to:
Conservation Division
State Corporation Commission
800 Biting Building
Wichita, Kansas

Rooks County, Sec. 6 Twp. 10 Rge. 20 (E) (W)

Location as "NE/CNW $\frac{1}{4}$ SW $\frac{1}{4}$ " or footage from lines E/2 NE NE
Lease Owner B & R DRILLING, INC.
Lease Name HINKHOUSE Well No. #1
Office Address RUSSELL, KANSAS
Character of Well (completed as Oil, Gas or Dry Hole) DRY HOLE
Date well completed 12/17/49 19
Application for plugging filed December 15, 1949 Verbally 19
Application for plugging approved December 15, 1949 Verbally 19
Plugging commenced December 16, 1949 19
Plugging completed December 16, 1949 19
Reason for abandonment of well or producing formation DRY HOLE

NORTH

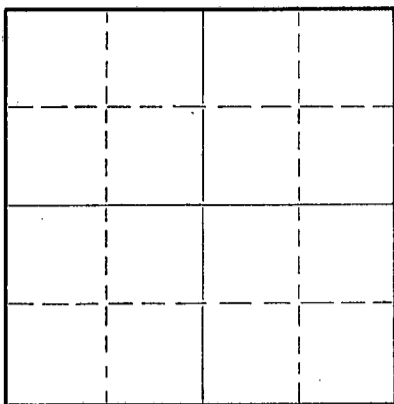

Locate well correctly on above
Section Plat

If a producing well is abandoned, date of last production 19
Was permission obtained from the Conservation Division or its agents before plugging was commenced? Yes

Name of Conservation Agent who supervised plugging of this well Eldon Petty
Producing formation Depth to top Bottom Total Depth of Well 3940 Feet
Show depth and thickness of all water, oil and gas formations.

OIL, GAS OR WATER RECORDS

CASING RECORD

Formation	Content	From	To	Size	Put In	Pulled Out
				8 5/8"	180'	None

Describe in detail the manner in which the well was plugged, indicating where the mud fluid was placed and the method or methods used in introducing it into the hole. If cement or other plugs were used, state the character of same and depth placed, from feet to feet for each plug set.

Plugging

Fill hole with Heavy Mud to 180' Plug at 180'
15 Sacks Cement through Drill Pipe at 180'
Fill hole to 30 ft. with heavy mud-Woodend
plug and 10 Sacks cement. Tie topplug to Surface
Pipe.

Conservation Div.
JAN 3 1950
01-03-1950
STATE CORPORATION COMMISSION

(If additional description is necessary, use BACK of this sheet)

Correspondence regarding this well should be addressed to B & R DRILLING, INC.
Address RUSSELL, KANSAS

STATE OF KANSAS, COUNTY OF RUSSELL, ss.
DON ROBERTS (employee of owner) or (owner or operator) of the above-described well,
being first duly sworn on oath, says: That I have knowledge of the facts, statements, and matters herein contained and the log of the above-described well as filed and that the same are true and correct. So help me God.

(Signature) *Don Roberts*
RUSSELL, KANSAS (Address)

SUBSCRIBED AND SWORN TO before me this 27 th day of DECEMBER, 1949.

Clara Hummel
Notary Public.

My commission expires 6-17-50

PLUGGING
FILE SEC 6-T-10 R226
BOOK PAGE 134 LINE 9

B & R DRILLING, INC.
HINKHOUSE # 1

Sec. 6 Twp. 10 Rge. 20
Rooks County, Kansas

Total Depth: 3940'
Comm: 12/1/49
Comp: 12/17/49

15-163-03310-00-00

Casing
8 5/8" Set @ 180'

Cement
125 Sacks

Formation	Depth
Surface Clay-Sand	20
Sand-Shale	180
Shale	740
Sand-Shale	1145
Sand	1190
Shale-Shells-Sand	1290
Sand	1500
Red Bed-Shale	1680
Shale-Lime	1795
Anhydrite	1823
Shale-Red Bed-Shells	1910
Shale-Lime	2390
Lime-Shale-Pyrite	2405
Lime	2435
Shale-Lime-Shells	2450
Lime-Shale	2475
Lime-Sand	2520
Shale-Shells-Pyrite	2545
Shale-Lime	2585
Shale-Shells	2640
Shells-Lime-Shale	2660
Lime-Pyrite	2690
Lime-Shale	2845
Shale	2935
Lime-Shale	2985
Lime-Shale-Pyrite	3045
Lime-Shale	3277
Lime	3858
Conglomerate	3899
Conglomerate	3940

STATE OF KANSAS)
)SS
RUSSELL COUNTY)

I hereby certify that the above information is true and
Correct to the best of my knowledge.

Subscribed and sworn to before me this 27th day of December, 1949

Violet Keller
.....
Clara Lummus
.....
Notary Public

My commission expires: 6-17-50

PLUGGING
FOR SEC. 6 T. 10. R. 20W
BOOK PAGE 31 LINE 9

RECEIVED
DEC 28 1949
01-03-1950
DIV. OF REVENUE
STATE OF KANSAS