


Give All Information Completely
Make Required Affidavit
Mail or Deliver Report to:
Conservation Division
State Corporation Commission
211 No. Broadway
Wichita, Kansas

WELL PLUGGING RECORD

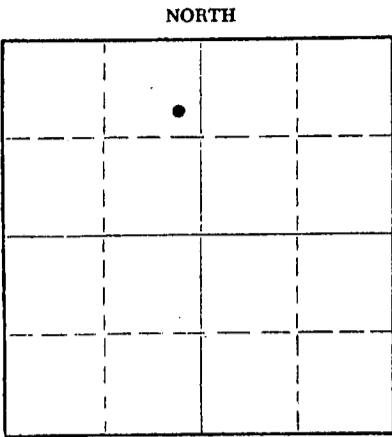

Locate well correctly on above
Section Plat

Rooks County. Sec. 6 Twp. 10 Rge. (E) 20 (W)
Location as "NE/CNW/SW" or footage from lines SE/4 NE/4 NW/4
Lease Owner Dane G. Hansen Trust
Lease Name Wolf Well No. 2
Office Address Box 187, Logan, Kansas 67646
Character of Well (completed as Oil, Gas or Dry Hole) Oil
Date well completed June 6 19 56
Application for plugging filed December 30 19 75
Application for plugging approved December 31 19 75
Plugging commenced January 30 19 76
Plugging completed January 30 19 76
Reason for abandonment of well or producing formation Oil depleted

If a producing well is abandoned, date of last production 19
Was permission obtained from the Conservation Division or its agents before plugging was commenced? Yes

Name of Conservation Agent who supervised plugging of this well Leo Massey
Producing formation Arbuckle Depth to top 3862 Bottom 3869 Total Depth of Well 3869 Feet
Show depth and thickness of all water, oil and gas formations.

OIL, GAS OR WATER RECORDS

CASING RECORD

FORMATION	CONTENT	FROM	TO	SIZE	PUT IN	PULLED OUT
				8 5/8"	170	None
				5 1/2"	3863	None

Describe in detail the manner in which the well was plugged, indicating where the mud fluid was placed and the method or methods used in introducing it into the hole. If cement or other plugs were used, state the character of same and depth placed, from feet to feet for each plug set.

Mixed 2 sacks hulls with water.
Mixed 100 sacks cement with water. Pumped down.
Started with 1200# max. pressure and had 200# at finish.

RECEIVED
STATE CORPORATION COMMISSION

MAR 19 1976
03-19-1976
CONSERVATION DIVISION
Wichita, Kansas

(If additional description is necessary, use BACK of this sheet)
Name of Plugging Contractor Allied Cementing Company
Address Box 31, Russell, Kansas


STATE OF KANSAS, COUNTY OF PHILLIPS, ss.
Dane G. Bales, Manager (employee of owner) or (owner or operator) of the above-described well, being first duly sworn on oath, says: That I have knowledge of the facts, statements, and matters herein contained and the log of the above-described well as filed and that the same are true and correct. So help me God.

(Signature) Dane G. Bales
Dane G. Bales
Logan, Kansas 67646 (Address)

SUBSCRIBED AND SWORN TO before me this 17 day of March 19 76

Betty Jane Bittel
Betty Jane Bittel Notary Public.

My commission expires

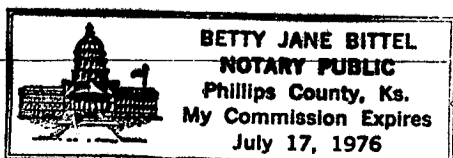

15-163-03225-00-00

CONTRACTOR'S WELL LOG

OPERATOR D. G. HANSEN WELL NAME WOLF #2

LOCATION SE NE NW SECTION 6-10-20 RIG NO. 1

COUNTY _____ ROCKS _____ STATE KANSAS

COMMENCEMENT DATE MAY 23, 1956 COMPLETION DATE JUNE 8, 1956

LOG OF WELL

Elevation 2275' rotary bushing.
All measurements taken from the top of rotary bushing.

FROM	TO	FORMATION	DEVIATION FROM VERTICAL	REMARKS
0	170	Surface Soil		
170	690	Shale		
690	760	Sand		
760	940	Shale		
940	1030	Sand		
1030	1260	Shale		
1260	1505	Sand		
1505	1764	Red Bed		
1764	1803	Anhydrite		
1803	2040	Shale-Sand		
2040	2300	Lime-Shale		
2300	2435	Lime-Shale		
2435	2540	Lime-Shale	0° - 2500	
2540	2685	Lime-Shale		
2685	2775	Lime-Shale	0° - 2750	
2775	2885	Lime-Shale		
2885	2980	Lime-Shale		
2980	3045	Lime-Shale	0° - 3000	
3045	3150	Lime-Shale		
3150	3253	Lime-Shale	0° - 3250	
3253	3350	Lime-Shale		
3350	3410	Lime-Shale		
3410	3509	Lime-Shale	0° - 3500	
3509	3620	Lime-Shale		
3620	3709	Lime-Shale		
3709	3819	Lime-Shale	0° - 3750	DST 3631-3641'
3819	3868	Lime-Shale		DST 3863-3868'

RECEIVED
STATE CORPORATIONS COMMISSION
10-09-1973
OCT 9 1973
CONSERVATION DIVISION
Wichita, Kansas

CASING LEFT IN HOLE AFTER COMPLETION

170' 8-5/8" OD Surface Casing
Ran 3863' (120 jts.) 5-1/2" Casing

STATE OF KANSAS, COUNTY OF SEDGWICK) SS.

The undersigned hereby certifies that to the best of his knowledge and belief, the above facts are true and correct.

C-G DRILLING CO.

By Jay H. Galloway
Jay H. Galloway

Subscribed and sworn to before me this 6th day of June, 1956.

My commission expires:
May 20, 1959

Vicky Jacobs
Vicky Jacobs, Notary Public

