


15-163-03397-00-00

WELL PLUGGING RECORD

Give All Information Completely
Make Required Affidavit
Mail or Deliver Report to:
Conservation Division
State Corporation Commission
800 Biting Building
Wichita, Kansas

NORTH

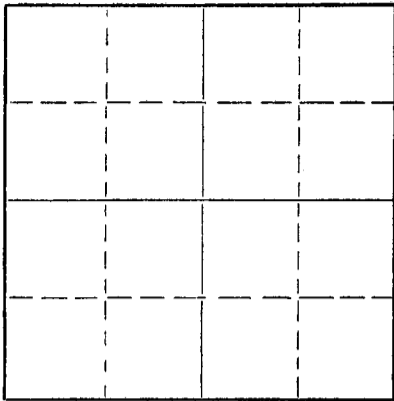

Locate well correctly on above
Section Plat

Rooks County. Sec. 10 Twp. 10 Rge. 20 (E) W (W)
Location as "NE/CNW $\frac{1}{4}$ SW $\frac{1}{4}$ " or footage from lines NW NE SW
Lease Owner B & R Drilling, Inc.
Lease Name Downey Well No. 5
Office Address Russell, Kansas
Character of Well (completed as Oil, Gas or Dry Hole) Dry
Date well completed 6/22/52 19
Application for plugging filed 6/21/52 19
Application for plugging approved 6/21/52 19
Plugging commenced 6/22/52 19
Plugging completed 6/22/52 19
Reason for abandonment of well or producing formation Dry Hole

If a producing well is abandoned, date of last production _____ 19
Was permission obtained from the Conservation Division or its agents before plugging was commenced? Yes

Name of Conservation Agent who supervised plugging of this well Eldon Petty
Producing formation _____ Depth to top _____ Bottom _____ Total Depth of Well 3843 Feet
Show depth and thickness of all water, oil and gas formations.

OIL, GAS OR WATER RECORDS

CASING RECORD

FORMATION	CONTENT	FROM	TO	SIZE	PUT IN	PULLED OUT
				8 5/8"	199	None

Describe in detail the manner in which the well was plugged, indicating where the mud fluid was placed and the method or methods used in introducing it into the hole. If cement or other plugs were used, state the character of same and depth placed, from _____ feet to _____ feet for each plug set.

PLUGGING RECORD

Finish plugging hole. Filled hole to 180' with heavy mud, first plug set at 180' with 15 sacks of cement. Filled hole to 43' of top and set second plug at 43' with $\frac{1}{2}$ sack of hulls and 10 sacks of cement.

(If additional description is necessary, use BACK of this sheet)

Name of Plugging Contractor _____
Address _____

STATE OF KANSAS, COUNTY OF RUSSELL, ss.
Don Roberts (employee of owner) or (owner or operator) of the above-described well, being first duly sworn on oath, says: That I have knowledge of the facts, statements, and matters herein contained and the log of the above-described well as filed and that the same are true and correct. So help me God.

(Signature) [Signature]
Russell, Kansas
(Address)

SUBSCRIBED AND SWORN to before me this 7th day of July, 19 52

My commission expires 6-17-54.

24-2675-S 2-52-20M

PLUGGING
FILE SEC 10 T 10 R 20
BOOK PAGE 26 LINE 23

RECEIVED
STATE CORPORATION COMMISSION
JUL - 9 1952
07-09-1952
CONSERVATION DIVISION
Wichita, Kansas
Notary Public.

J & H Drilling, Inc.
Downey #5

NW NE SW 10-10-20
Hook County, Kansas

15-163-03397-00-00

Total Depth: 3843'
Comm. 6/10/52
Comp. 6/22/52

Casing

Cement

8 5/8" Set @ 199'

130 sacks of Lone Star

Formation	Depth
Sand-rock-shale	160
Shale-shells	825
Sand-shale	1020
Shale-shells	1120
Sand-shale	1500
Shale-shells	1650
Shale-red bed	1705
Anhydrite	1730
Shale-shells	2075
Shale	2260
Shale-lime	2420
Lime	2520
Shale-lime	3535
Lime	3843'

STATE OF KANSAS)
) ss
RUSSELL COUNTY)

I hereby certify that the above information is true and correct to the best of my knowledge.

Lawyer

Subscribed and sworn to before me this 7th day of July, 1952.

Notary

Notary Public

My commission expires: 6-17-54.

RECORDED
STATE OF KANSAS
07-09-1952
COMMERCIAL
Missouri

PLUGGING
FILE SEC 10 T 10 R 30
BOOK PAGE 26 LINE 23