


STATE OF KANSAS
STATE CORPORATION COMMISSION

Give All Information Completely
Make Required Affidavit
Mail or Deliver Report to:
Conservation Division
State Corporation Commission
212 North Market, Insurance Bldg.
Wichita, Kansas

15-065-20922-00-00
WELL PLUGGING RECORD

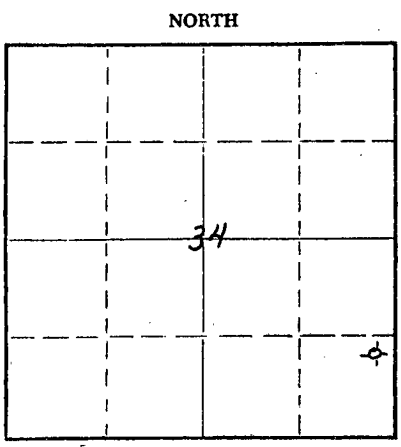

Graham County, Sec. 34 Twp. 9S Rge. 24W (E) (W)
Location as "NE/CNW/SW" or footage from lines NE SE SE
Lease Owner Petroleum, Inc.
Lease Name KURTZ #1 Well No.
Office Address 800 R.H. Garvey Bldg., Wichita, Ks. 67202
Character of Well (completed as Oil, Gas or Dry Hole) Dry Hole
Date well completed 5-5-77 19
Application for plugging filed Yes 19
Application for plugging approved 19
Plugging commenced 19
Plugging completed 1:45 A.M. 5-5-77 19
Reason for abandonment of well or producing formation

Locate well correctly on above Section Plat

If a producing well is abandoned, date of last production 19
Was permission obtained from the Conservation Division or its agents before plugging was commenced? Yes

Name of Conservation Agent who supervised plugging of this well Gilbert Balthazar
Producing formation Depth to top Bottom Total Depth of Well Feet
Show depth and thickness of all water, oil and gas formations.

OIL, GAS OR WATER RECORDS

CASING RECORD

FORMATION	CONTENT	FROM	TO	SIZE	PUT IN	PULLED OUT

Describe in detail the manner in which the well was plugged, indicating where the mud fluid was placed and the method or methods used in introducing it into the hole. If cement or other plugs were used, state the character of same and depth placed, from feet to feet for each plug set.

Plug #1 1150' 70 sx.
Plug #2 200' 20 sx.
Plug #3 40' 10 sx.

RECEIVED
STATE CORPORATION COMMISSION
MAY 26 1977
05-26-1977
CONSERVATION DIVISION
Wichita, Kansas

(If additional description is necessary, use BACK of this sheet)
Name of Plugging Contractor John O. Farmer, Inc.
Address Box 352, Russell, Kansas 67665

STATE OF KANSAS, COUNTY OF BARTON, ss.
MONTE CHADD (employee of owner) or (owner or operator) of the above-described well, being first duly sworn on oath, says: That I have knowledge of the facts, statements, and matters herein contained and the log of the above-described well as filed and that the same are true and correct. So help me God.

(Signature) MONTE CHADD
800 R.H. Garvey Bldg., Wichita, Ks. 67202
(Address)

Subscribed and sworn to before me this 12 day of MAY, 19 77
My commission expires MAY 28, 1977
Richard H. Dumbler Notary Public.

