


Give All Information Completely  
Make Required Affidavit  
Mail or Deliver Report to:  
Conservation Division  
State Corporation Commission  
212 No. Market  
Wichita, Kansas

WELL PLUGGING RECORD

GRAHAM County, Sec. 35 Twp. 9S Rge. 24 (E) W(W)

Location as "NE/CNW/SW" or footage from lines NW NW SW  
Lease Owner GEORGE A. REED  
Lease Name #1 ELMER Well No. 1  
Office Address 1223 UNION NATIONAL BLDG., WICHITA, KANSAS 67202  
Character of Well (completed as Oil, Gas or Dry Hole) DRY HOLE  
Date well completed FEBRUARY 2 1970  
Application for plugging filed FEBRUARY 2 1970  
Application for plugging approved FEBRUARY 2 1970  
Plugging commenced FEBRUARY 2 1970  
Plugging completed FEBRUARY 2 1970  
Reason for abandonment of well or producing formation TOO LOW STRUCTURALLY

NORTH

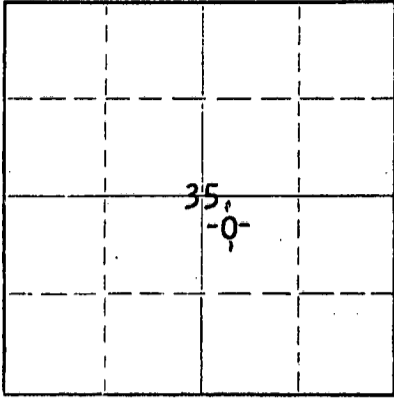

Locate well correctly on above Section Plat

If a producing well is abandoned, date of last production \_\_\_\_\_ 19\_\_\_\_  
Was permission obtained from the Conservation Division or its agents before plugging was commenced? YES

Name of Conservation Agent who supervised plugging of this well W. L. NICHOLS, MORELAND, KS.  
Producing formation \_\_\_\_\_ Depth to top \_\_\_\_\_ Bottom \_\_\_\_\_ Total Depth of Well 4060 Feet  
Show depth and thickness of all water, oil and gas formations.

OIL, GAS OR WATER RECORDS

CASING RECORD

FORMATION	CONTENT	FROM	TO	SIZE	PUT IN	PULLED OUT
				8 5/8"	201.43	NONE

Describe in detail the manner in which the well was plugged, indicating where the mud fluid was placed and the method or methods used in introducing it into the hole. If cement or other plugs were used, state the character of same and depth placed, from \_\_\_\_\_ feet to \_\_\_\_\_ feet for each plug set.

FILLED WITH HEAVY MUD TO 1225'. SET PLUG.  
PUT IN 100 SACKS CEMENT. FILLED WITH HEAVY MUD TO 215'. SET PLUG. PUT IN 25 SACKS CEMENT. FILLED WITH HEAVY MUD UP TO 40'. SET PLUG. FILLED TO TOP WITH 1 SACK HULLS AND 10 SACKS CEMENT.

RECEIVED  
STATE CORPORATION COMMISSION  
FEB 13 1970  
CONSERVATION DIVISION  
Wichita, Kansas  
02-13-1970

Name of Plugging Contractor C-G DRILLING CO.  
Address 1107 UNION NATIONAL BLDG., WICHITA, KANSAS 67202


STATE OF KANSAS COUNTY OF SEDGWICK, ss.  
JAY H GALLOWAY (employee of owner) or (owner or operator) of the above-described

well, being first duly sworn on oath, says: That I have knowledge of the facts, statements, and matters herein contained and the log of the above-described well, as filed and that the same are true and correct. So help me God.

(Signature) Jay H Galloway  
1107 UNION NATIONAL BLDG. (Address)

Subscribed and sworn to before me this 6th day of FEBRUARY, 1970

My commission expires DECEMBER 7, 1971  
Phyllis Buchanan Notary Public.

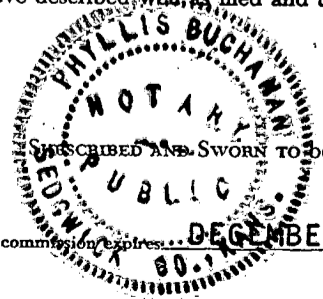

15-065-20304-00-00

WELL LOG

OPERATOR: GEORGE A REED

WELL NAME: ELMER #1 LOCATION: NW NW SW

COUNTY: GRAHAM STATE: KANSAS

WELL COMMENCED: JAN 24, 1970 WELL COMPLETED: FEBRUARY 2, 1970

ELEVATION: 2478 KB TOTAL DEPTH: 4060'

PRODUCTION: DRY & ABANDONED RIG NO: 1

CASING - 8-5/8": 5 JTS 201.43' W/160 SACKS POZMIX

5-1/2": \_\_\_\_\_

ALL MEASUREMENTS TAKEN FROM THE TOP OF ROTARY BUSHING:

FROM	TO	FORMATION	DEVIATION FROM VERTICAL	REMARKS:
0	760	SHALE & SAND		
760	1468	SHALE	1° 1000	
1468	1680	SHALE		
1680	1870	SAND		
1870	2118	RED BED		
2118	2156	ANHYDRITE		
2156	2330	SHALE & SHELLSS		
2330	2510	SHALE	3/4° 2500'	
2510	3668	LIME & SHALE		
3668	3765	LIME		
3765	3824	LIME & SHALE		
3824	3984	LIME		
3984	4060	LIME & SHALE		

RECEIVED  
STATE CORPORATION COMMISSION  
FEB 13 1970  
CONSERVATION DIVISION  
Wichita, Kansas

STATE OF KANSAS )  
COUNTY OF SEDGWICK) SS:

The undersigned hereby certifies that to the best of his knowledge and belief, the above facts are true and correct.

C-G DRILLING CO.

By J. H. Galloway

SUBSCRIBED AND SWORN TO, BEFORE ME, This 6th day of FEB, 1970.

DEC. 7, 1971

Phyllis Buchanan  
PHYLLIS BUCHANAN - NOTARY PUBLIC

