

Give All Information Completely  
Make Required Affidavit  
Mail or Deliver Report to:  
Conservation Division  
State Corporation Commission  
211 No. Broadway  
Wichita, Kansas

**WELL PLUGGING RECORD**

Graham County, Sec. 36 Twp. 9S Rge. 24 (E) W (W)  
Location as "NE/CNW/SW" or footage from lines. C E/2 SE/4

Lease Owner D. G. Hansen  
Lease Name George Gano Well No. 4  
Office Address Logan, Kansas

Character of Well (completed as Oil, Gas or Dry Hole) dry hole  
Date well completed May 22 1963

Application for plugging filed May 22 1963

Application for plugging approved May 22 1963


Plugging commenced May 22 1963

Plugging completed May 22 1963

Reason for abandonment of well or producing formation too low structurally

If a producing well is abandoned, date of last production -- 19---

Was permission obtained from the Conservation Division or its agents before plugging was commenced? yes

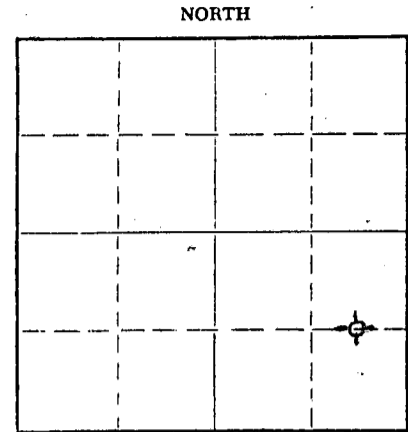

Locate well correctly on above Section Plat

Name of Conservation Agent who supervised plugging of this well W. L. Nichols

Producing formation \_\_\_\_\_ Depth to top \_\_\_\_\_ Bottom \_\_\_\_\_ Total Depth of Well \_\_\_\_\_ Feet

Show depth and thickness of all water, oil and gas formations.

**OIL, GAS OR WATER RECORDS**

**CASING RECORD**

FORMATION	CONTENT	FROM	TO	SIZE	PUT IN	PULLED OUT
				8-5/8"	203'	none

Describe in detail the manner in which the well was plugged, indicating where the mud fluid was placed and the method or methods used in introducing it into the hole. If cement or other plugs were used, state the character of same and depth placed, from \_\_\_\_\_ feet to \_\_\_\_\_ feet for each plug set.

Set plug at 540 feet. Filled with heavy mud and 20 sacks cement to 190'. Set plug and filled with 1/2 sack hulls & 20 sacks cement & heavy mud to 40'. Set plug and filled to top with 1/2 sack hulls & 10 sacks cement.

RECEIVED  
STATE CORPORATION COMMISSION

JUN 3 1963  
06-03-1963  
CONSERVATION DIVISION  
Wichita, Kansas

RECEIVED

MAY 30 1963

D. G. HANSEN  
Time.....

(If additional description is necessary, use BACK of this sheet)  
Name of Plugging Contractor C-G Drilling Co.  
Address 107 Rule Building, Wichita, Kansas

STATE OF Kansas, COUNTY OF Sedgwick, ss.  
G. F. Galloway (employee of owner) or (~~owner or operator~~) of the above-described

well, being first duly sworn on oath, says: That I have knowledge of the facts, statements, and matters herein contained and the log of the above-described well as filed and that the same are true and correct. So help me God.

(Signature) G. F. Galloway  
107 Rule Bldg., Wichita, Kansas  
(Address)

Subscribed and sworn to before me this 22 day of May, 19 63  
My commission expires May 20, 1967  
Vicky Jacobs Notary Public.

