


STATE CORPORATION COMMISSION

WELL PLUGGING RECORD

Give All Information Completely
Make Required Affidavit
Mail or Deliver Report to:
Conservation Division
State Corporation Commission
P. O. Box 17027
Wichita, Kansas 67217
NORTH

Graham County, Sec. 2 Twp. 9S Rge. 25W ~~(25)~~ XW
Location as "NE/CNW/SW" or footage from lines SE NE NE
Lease Owner Willie E. Schultz
Lease Name Richmeier "A" Well No. 2
Office Address Box 335, Ellinwood, Kansas 67526
Character of Well (completed as Oil, Gas or Dry Hole) Oil
Date well completed October 25 1978
Application for plugging filed October 23 1978
Application for plugging approved October 24 1978
Plugging commenced December 22 1978
Plugging completed December 22 1978
Reason for abandonment of well or producing formation non-commercial

If a producing well is abandoned, date of last production August 10, 1978
Was permission obtained from the Conservation Division or its agents before plugging was commenced? yes

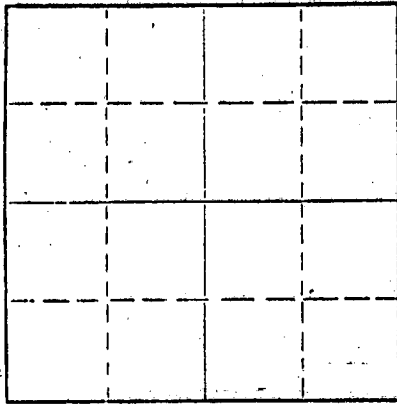

Locate well correctly on above Section Plat

Name of Conservation Agent who supervised plugging of this well Gilbert Balthazor
Producing formation Lansing Kansas City Depth to top 3847 Bottom 4056 Total Depth of Well 4065 Feet
Show depth and thickness of all water, oil and gas formations.

OIL, GAS OR WATER RECORDS

CASING RECORD

FORMATION	CONTENT	FROM	TO	SIZE	PUT IN	PULLED OUT
		0	150	8 5/8	150	none
		0	4064	5 1/2	4064	none

Describe in detail the manner in which the well was plugged, indicating where the mud fluid was placed and the method or methods used in introducing it into the hole. If cement or other plugs were used, state the character of same and depth placed, from _____ feet to _____ feet for each plug set.

Mixed 100 pounds hulls 30 sacks cement 853 pounds gel released plug pumped 30 sacks cement shut in.
Pumped 10 sacks cement down annulus shut in.

RECEIVED
STATE CORPORATION COMMISSION

JAN - 5 1979

1-5-79
CONSERVATION DIVISION
Wichita, Kansas

(If additional description is necessary, use BACK of this sheet)
Name of Plugging Contractor Sun Oil Well Cementing
Address Hays, Kansas 67601


STATE OF KANSAS, COUNTY OF BARTON, ss.
Willie E. Schultz (employee of owner) or (owner or operator) of the above-described well, being first duly sworn on oath, says: That I have knowledge of the facts, statements, and matters herein contained and the log of the above-described well as filed and that the same are true and correct. So help me God.

(Signature) Willie E. Schultz
Willie E. Schultz
Box 335, Ellinwood, Kansas 67526
(Address)

SUBSCRIBED AND SWORN to before me this 4th day of January, 1979

My commission expires July 16, 1982

Jenny Kasselmann
Jenny Kasselmann Notary Public.

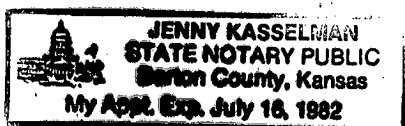

LOG

COMPANY: Empire Drilling Company
 CONTRACTOR: Empire Drilling Company
 FARM: Richmeier "A" # 2
 LOCATION: SE NE NE of Section 2-98-25W, Graham County, Kansas
 COMMENCED: October 12, 1961
 COMPLETED: October 25, 1961
 ELEVATION: 2536 KB
 POTENTIAL:

0	to	185	Surface Sand-Shale
185	to	1875	Shale
875	to	1770	Shale-Shells
1770	to	2010	Shale-Sand
2010	to	2213	Shale-Shells
2213	to	2244	Anhydrite
2244	to	2550	Shale-Shells
2550	to	3775	Shale-Lime
3775	to	3925	Lime
3925	to	3935	Lime-Shale
3935	to	4030	Lime
4030	to	4065	Lime-Shale
4065			Rotary Total Depth

SET: 150' of 8 5/8" casing with 75 sacks cement.
 4064' of 5 1/2" casing with 100 sacks cement.

ELECTRIC LOG TOPS:

Heebner	3806	-1270
Toronto	3831	-1295
Lansing	3847	-1311
Zone 2	3876	-1340
Zone 2 A	3889	-1353
Zone 3	3918	-1382
Zone 4	3929	-1393
Zone 5	3940	-1404
Zone 6	3982	-1446
Zone 6 A	4004	-1468
Zone 7	4022	-1486
Zone 8	4042	-1506
Zone 9	4056	-1520
Rotary Total Depth	4065	
Schlumberger TD	4065	

10-24-78

CERTIFICATION

I, Dan J. Kornfeld, do hereby certify that the above and foregoing is a true and correct copy of the log on the Richmeier "A" # 2, SE NE NE of Section 2-98-25W, Graham County, Kansas, as reflected by the files of Empire Drilling Company.

Dan J. Kornfeld
 Dan J. Kornfeld

Subscribed and sworn to before me, a Notary Public, within and for Sedgwick County, Kansas, this 31st day of October, 1961.



Lucille H. Harr
 Lucille H. Harr, Notary Public

My commission expires October 21, 1962.