

STATE OF KANSAS
STATE CORPORATION COMMISSION

WELL PLUGGING RECORD


OR

FORMATION PLUGGING RECORD

Strike out upper line when reporting plugging off formations.

Give All Information Completely
Make Required Affidavit
Mail or Deliver Report to:
Conservation Division
State Corporation Commission
800 Bitting Building
Wichita, Kansas

Graham County. Sec. 2 Twp. 9S Rge. (E) 25 (W)
Location as "NE $\frac{1}{4}$ NW $\frac{1}{4}$ SW $\frac{1}{4}$ " or footage from lines. SE $\frac{1}{4}$ -SE $\frac{1}{4}$ -NE $\frac{1}{4}$
Lease Owner. Champlin Refining Co.
Lease Name. Richmeier John J. Richmeier ^{CCC} Well No. 1
Office Address. P.O. Drawer #552 Enid, Oklahoma
Character of Well (completed as Oil, Gas or Dry Hole). Dry Hole
Date well completed. December 29 19 51
Application for plugging filed. December 28 19 51
Application for plugging approved. December 28 (Verbal) 19 51
Plugging commenced. December 29 19 51
Plugging completed. December 29 19 51
Reason for abandonment of well or producing formation.

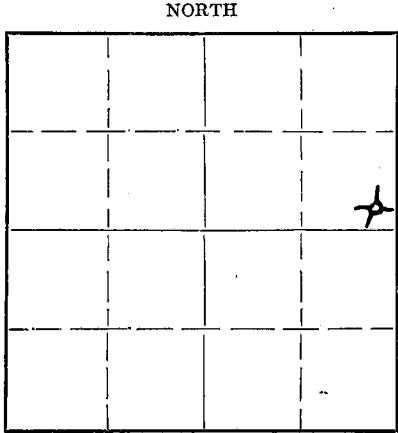

Locate well correctly on above Section Plat

If a producing well is abandoned, date of last production 19
Was permission obtained from the Conservation Division or its agents before plugging was commenced? Yes

Name of Conservation Agent who supervised plugging of this well. Eldon Petty, Hays, Kansas
Producing formation. Depth to top. Bottom. Total Depth of Well. 4578' Feet
Show depth and thickness of all water, oil and gas formations.

OIL, GAS OR WATER RECORDS

CASING RECORD

Formation	Content	From	To	Size	Put In	Pulled Out
				8 5/8" OD	161'	None

Describe in detail the manner in which the well was plugged, indicating where the mud fluid was placed and the method or methods used in introducing it into the hole. If cement or other plugs were used, state the character of same and depth placed, from feet to feet for each plug set.

Filled hole with heavy rotary mud from 4578' T.D. to 155' and set Halliburton plug and cement bridge using 15 sacks cement then filled hole with heavy rotary mud from top of cement to 40' and dumped in 1/2 sack of hulls and set bridge in top from 40' to bottom of cellar using 10 sacks of cement.

Used Halliburton to help plug this well.

ST. RECEIVED
JAN - 8 1952
CO. CONSERVATION DIVISION
WICHITA, KANSAS

1-8-52
Correspondence regarding this well should be addressed to Champlin Refining Company
Address. P.O. Drawer #552 Enid, Oklahoma

STATE OF Kansas, COUNTY OF Barton, ss.
S. P. Hall (employee of owner) or (owner or operator) of the above-described well,
being first duly sworn on oath, says: That I have knowledge of the facts, statements, and matters herein contained and the log of the above-described well as filed and that the same are true and correct. So help me God.

(Signature) S. P. Hall
P.O. Box 167
Ellinwood, Kansas (Address)



Subscribed and sworn to before me this 7th day of January 1955
My commission expires September 10, 1955
Notary Public. N. Kenneth Steen

PLUGGING
WELL SEC 2 T 9 R 25
Box 38

JOHN J. RICHMEIER #1

2310' from the North line (FNL) and
330' from the East line (FEL) of the
Northeast Quarter (NE/4) of Section
Two(2), Township Nine South (9S),
Range Twenty-five West (25W), Graham
County, Kansas

Formation Log

0' -160'	Sand & surface clay
160' -520'	Shale & sand
520' -1060'	Sand & shale
1060' -1580'	Shale, sand & shells
1580' -1868'	Shale & sand
1868' -2235'	Shale & redbed
2235' -2295'	Lime & shale
2295' -2515'	Shale & shells
2515' -2775'	Shale & lime
2775' -2920'	Shale, lime & shells
2920' -3140'	Lime & shale
3140' -3285'	Lime
3285' -3329'	Lime & shale
3329' -3337'	Lime
3337' -3588'	Lime & shale
3588' -3690'	Lime
3690' -3920'	Lime & shale
3920' -4147'	Lime
4147' -4155'	Lime & shale
4155' -4215'	Shale & cherty lime
4215' -4337'	Lime & shale
4337' -4388'	Lime & shale
4388' -4394'	Red & green shale
4394' -4455'	Conglomerate
4455' -4497'	Lime
4497' -4533'	Conglomerate
4533' -4578'	Lime
4578' -Total	Depth

RECEIVED
STATE CORPORATION COMMISSION

JAN - 8 1952

CONSERVATION DIVISION
Wichita, Kansas

1 - 8 - 52

PLUGGING
FILE SEC-2-T-9-R-250
BOOK PAGE 134 LINE 38