


STATE OF KANSAS  
STATE CORPORATION COMMISSION

Give All Information Completely  
Make Required Affidavit  
Mail or Deliver Report to:  
Conservation Division  
State Corporation Commission  
211 No. Broadway  
Wichita, Kansas

WELL PLUGGING RECORD

NORTH

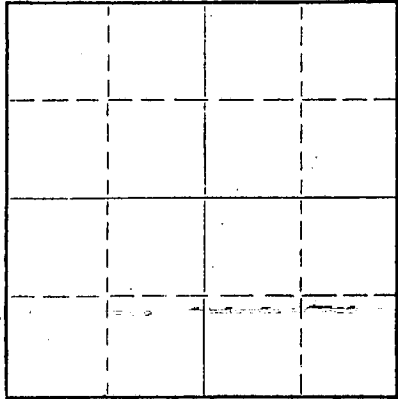

Locate well correctly on above  
Section Plat

Graham County. Sec. 3 Twp. 9 Rge. 25W (E) (W)  
Location as "NE/CNW&SW&" or footage from lines NE SW NE  
Lease Owner Chief Drilling Co., Inc. and A. J. Gebert  
Lease Name Keith Well No. #1  
Office Address Suite 905 Century Plaza, Wichita, Kansas  
Character of Well (completed as Oil, Gas or Dry Hole) Dry hole  
Date well completed 1/15/71 19  
Application for plugging filed 1/15/71 19  
Application for plugging approved 1/15/71 19  
Plugging commenced 1/15/71 19  
Plugging completed 1/15/71 19  
Reason for abandonment of well or producing formation Dry hole

If a producing well is abandoned, date of last production \_\_\_\_\_ 19\_\_\_\_  
Was permission obtained from the Conservation Division or its agents before plugging was commenced? Yes

Name of Conservation Agent who supervised plugging of this well Bill Nichols  
Producing formation \_\_\_\_\_ Depth to top \_\_\_\_\_ Bottom \_\_\_\_\_ Total Depth of Well 4050 Feet  
Show depth and thickness of all water, oil and gas formations.

OIL, GAS OR WATER RECORDS

CASING RECORD

FORMATION	CONTENT	FROM	TO	SIZE	PUT IN	PULLED OUT
		0	221	8 5/8"		

Describe in detail the manner in which the well was plugged, indicating where the mud fluid was placed and the method or methods used in introducing it into the hole. If cement or other plugs were used, state the character of same and depth placed, from \_\_\_\_\_ feet to \_\_\_\_\_ feet for each plug set.

Plugged through drill pipe @ 1200' w/100 sacks cement  
Plugged through drill pipe @ 250' w/25 sacks cement  
Plugged through drill pipe @ 40' w/10 sacks cement


RECEIVED  
STATE CORPORATION COMMISSION  
JAN 18 1971  
CONSERVATION DIVISION  
Wichita, Kansas  
1-18-71

(If additional description is necessary, use BACK of this sheet)  
Name of Plugging Contractor Chief Drilling Co., Inc.  
Address Suite 905 Century Plaza, Wichita, Kansas 67202

STATE OF KANSAS, COUNTY OF SEDGWICK, ss.  
Jim Robinson (employee of owner) or (~~owner or operator~~) of the above-described well, being first duly sworn on oath, says: That I have knowledge of the facts, statements, and matters herein contained and the log of the above-described well as filed and that the same are true and correct. So help me God.

(Signature) Jim Robinson  
Suite 905 Century Plaza, Wichita, Kansas  
(Address)

Subscribed and Sworn to before me this 15th day of January, 1971

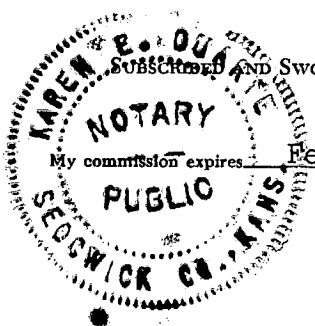

Karen E. Duarte  
Notary Public.

RECEIVED  
STATE CORPORATION COMMISSION

JAN 19 1971

CONSERVATION DIVISION

Wichita, Kansas

1-19-71

WELL LOG

Chief Drilling Co., Inc. & A. J. Gebert  
Suite 905 Century Plaza  
Wichita, Kansas 67202

#1 KEITH  
NE SW NE Sec. 3-9-25W  
Graham County, Kansas

CONTRACTOR: Chief Drilling Co., Inc.  
CASING RECORD: Set 221' of 8 5/8" w/150 sacks cement

COMMENCED: 1/7/71  
COMPLETED: 1/15/71

<u>FORMATION</u>	<u>FROM</u>	<u>TO</u>	<u>ELEVATION</u>
Sand	0	100	2509 Gr.
Shale & sand	100	1600	2511 D.F.
Shale, shells & sand	1600	1920	2514 K.B.
Shale & shells	1920	2198	
Anhydrite	2198	2232	
Shale & shells	2232	2258	
Shale & Lime	2258	3860	
Lime	3860	4050	
T.D.	4050		

<u>FORMATION TOPS</u>	
Anhy.	2198 + 316
Base Anhy.	2232 + 282
Topeka	3558 -1044
Heebner	3770 -1256
Toronto	3795 -1281
Lansing	3812 -1298
Base K.C.	4033 -1519
T.D.	4050 -1536

STATE OF KANSAS, COUNTY OF SEDGWICK) ss:

I hereby certify that the above is a true and correct copy of the Driller's Log of the well drilled in the NE SW NE of Section 3-9-25W, Graham County, Kansas, to the best of my knowledge and belief.

CHIEF DRILLING CO., INC.

By- Jim Robinson  
Jim Robinson, Office Manager

Subscribed and sworn to before me this 18th day of January, 1971

Karen E. Duarte  
Karen E. Duarte, Notary Public

