


15-065-20778-00-00

STATE OF KANSAS
STATE CORPORATION COMMISSION

Form CP-4

WELL PLUGGING RECORD

Give All Information Completely
Make Required Affidavit
Mail or Deliver Report to:
Conservation Division
State Corporation Commission
P. O. Box 17027
Wichita, Kansas 67217
NORTH

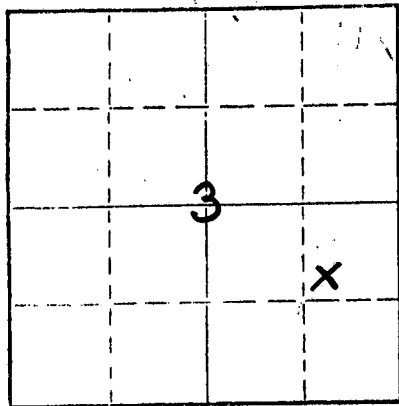

Locate well correctly on above
Section Plat

Graham County, Sec. 3 Twp. 9S Rge. 25 (W)
Location as "NE/CNW/SW" or footage from lines SW NE SE
Lease Owner Kansas Petroleum, Inc.
Lease Name DINKEL Well No. #1
Office Address 500 Insurance Bldg. Wichita, Kansas
Character of Well (completed as Oil, Gas or Dry Hole) Dry Hole
Date well completed September 29, 19 75
Application for plugging filed September 29, (verbally) 19 75
Application for plugging approved September 29, (verbally) 19 75
Plugging commenced September 29, 19 75
Plugging completed September 29, 19 75
Reason for abandonment of well or producing formation No commercial quantity
of oil or gas encountered.

If a producing well is abandoned, date of last production 19
Was permission obtained from the Conservation Division or its agents before plugging was com-
menced? Yes

Name of Conservation Agent who supervised plugging of this well Gilbert Balthazor
Producing formation _____ Depth to top _____ Bottom _____ Total Depth of Well 4053' Feet
Show depth and thickness of all water, oil and gas formations.

OIL, GAS OR WATER RECORDS

CASING RECORD

FORMATION	CONTENT	FROM	TO	SIZE	PUT IN	PULLED OUT
				8 5/8"	216.22	None

Describe in detail the manner in which the well was plugged, indicating where the mud fluid was placed and the method or methods used
in introducing it into the hole. If cement or other plugs were used, state the character of same and depth placed, from _____ feet to
_____ feet for each plug set.

1st Plug Set @ 1200' with 70 sx. cement
2nd Plug Set @ 200' with 20 sx. cement
3rd Plug Set @ 40' with 10 sx. cement
Plug was down @ 10:15 a.m. September 29, 1975

RECEIVED
STATE CORPORATION COMMISSION

OCT 2 1975

CONSERVATION DIVISION
Wichita, Kansas

10-2-75

(If additional description is necessary, use BACK of this sheet)

Name of Plugging Contractor Abercrombie Drilling, Inc.
Address 801 Union Center, Wichita, Kansas 67202

STATE OF KANSAS COUNTY OF SEDGWICK SS.
Jack L. Partridge-Asst. Sec. Treas. (employee of owner) or (owner or operator) of the above-described
well, being first duly sworn on oath, says: That I have knowledge of the facts, statements, and matters herein contained and the log of the
above-described well as filed and that the same are true and correct. So help me God.

(Signature) Jack L. Partridge
801 Union Center, Wichita, Kansas 67202
(Address)

Subscribed AND SWORN TO before me this 30th day of September, 19 75

July 21, 1979

Sandra Russell
Notary Public.



OPERATOR:	Kansas Petroleum, Inc.
CONTRACTOR:	Abercrombie Drilling, Inc.
WELL NAME:	DINKEL #1
LOCATION:	SW NE SE Section 3-9S-25W Graham County, Kansas
GEOLOGIST:	Dick Roby
SPUD DATE:	September 23, 1975
COMPLETION DATE:	September 29, 1975

0	155	Surface clay and Sand
155	225	Shale
225	335	Sand & Shale
335	1200	Shale
1200	2100	Shale & Sand
2100	2222	Sand & Shale
2222	2257	Anhydrite
2257	2485	Sand and Shale
2485	3465	Shale
3465	3898	Shale & Lime
3898	4053	Lime
	4053	Rotary Total Depth

RECEIVED
STATE CORPORATION COMMISSION

OCT 2 1975

CONSERVATION DIVISION
Wichita, Kansas

10-2-75

Spudded in @ 10:00 a.m. September 23, 1975. Cut 220' of 12 1/4" hole. Ran 5 jts. used 8 5/8" casing. Set @ 216.22'. Cemented by Halliburton with 165 sx. cement. Plug was down @ 1:15 p.m. September 23, 1975.

Plugged and Abandoned: 1st Plug Set @ 1200' with 70 sx. cement; 2nd Plug Set @ 200' with 20 sx. cement; 3rd Plug Set @ 40' with 10 sx. cement. State Plugger: Gilbert Balthazor Plug was down @ 10:15 a.m. September 29, 1975.

<u>SAMPLE TOPS:</u>		<u>ELEVATION:</u>
Anhydrite	2223	2536' K.B.
B/Anhydrite	2257	2534' D.F.
		2531' G.L.

STATE OF KANSAS)
) SS
COUNTY OF SEDGWICK)

Jack L. Partridge, Asst. Sec. Treas. of Abercrombie Drilling, Inc. does hereby state that the above and foregoing is a true and correct copy of the log of the DINKEL #1, SW NE SE, Section 3-9S-25W, Graham County, Kansas.

ABERCROMBIE DRILLING, INC.

By: Jack L. Partridge
Jack L. Partridge

Subscribed and sworn to before me, a Notary Public, in and for the aforesaid county and state as of this 1st day of October, 1975.

Sandra Russell
Sandra Russell-Notary Public

My Commission Expires: July 21, 1979

