


STATE OF KANSAS  
STATE CORPORATION COMMISSION

WELL PLUGGING RECORD

Give All Information Completely  
Make Required Affidavit  
Mail or Deliver Report to:  
Conservation Division  
State Corporation Commission  
211 No. Broadway  
Wichita, Kansas

NORTH

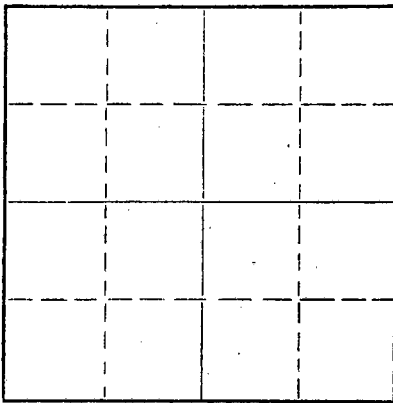

Locate well correctly on above  
Section Plat

Graham County. Sec. 4 Twp. 9S Rge. 25W (E) (W)  
Location as "NE/CNW4SW4" or footage from lines NW NW SE  
Lease Owner Imperial Oil of Kansas, Inc.  
Lease Name Minimum "A" Well No. 1  
Office Address Wichita, Kansas  
Character of Well (completed as Oil, Gas or Dry Hole) Dry Hole  
Date well completed February 7, 19 58  
Application for plugging filed February 7, 19 58  
Application for plugging approved February 7, 19 58  
Plugging commenced February 7, 19 58  
Plugging completed February 7, 19 58  
Reason for abandonment of well or producing formation No commercial quantities of oil found.

If a producing well is abandoned, date of last production \_\_\_\_\_ 19\_\_\_\_  
Was permission obtained from the Conservation Division or its agents before plugging was commenced? Yes

Name of Conservation Agent who supervised plugging of this well A. D. Fabricius, Box 731, Hill City, Ks.  
Producing formation \_\_\_\_\_ Depth to top \_\_\_\_\_ Bottom \_\_\_\_\_ Total Depth of Well 4600 Feet  
Show depth and thickness of all water, oil and gas formations.

OIL, GAS OR WATER RECORDS

CASING RECORD

FORMATION	CONTENT	FROM	TO	SIZE	PUT IN	PULLED OUT
				8-5/8"	1-21-58	

Describe in detail the manner in which the well was plugged, indicating where the mud fluid was placed and the method or methods used in introducing it into the hole. If cement or other plugs were used, state the character of same and depth placed, from \_\_\_\_\_ feet to \_\_\_\_\_ feet for each plug set.

Plugged hole at 550 feet with 25  
sacks cement. Set No. 2 plug at  
220' with 15 sacks and No. 3 plug  
at 40' with 10 sacks cement.

RECEIVED  
STATE CORPORATION COMMISSION

FEB 24 1958

CONSERVATION DIVISION  
Wichita, Kansas

2-24-58


(If additional description is necessary, use BACK of this sheet)  
Name of Plugging Contractor Imperial Oil of Kansas, Inc.  
Address 780 Fourth National Building, Wichita 2, Kansas

STATE OF KANSAS COUNTY OF SEDGWICK, ss.  
Stanley J. Bounds

(employee of ~~Imperial Oil of Kansas, Inc.~~) of the above-described well, being first duly sworn on oath, says: That I have knowledge of the facts, statements, and matters herein contained and the log of the above-described well as filed and that the same are true and correct. So help me God.

(Signature) By: Stanley J. Bounds V-P  
780 Fourth National Bldg. Wichita 2, Kansas  
(Address)

SUBSCRIBED AND SWORN TO before me this 21st day of February, 19 58

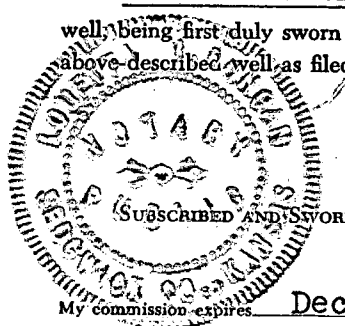

Louetta M. Duncan  
Louetta M. Duncan  
Notary Public.

PLUGGING  
FILE SEC. 4 T. 9 R. 25W  
BOOK PAGE 81 LINE 34



DRILLER'S LOG

Imperial Oil of Kansas, Inc.  
780 Fourth National Building  
Wichita 2, Kansas

Mimum "A" No. 1  
NW NW SE Sec. 4-9S-25W  
Graham County, Kansas

Total Depth: 4600'

Elevation: 2531' RB  
Production: D & A

Commenced: 1-21-58 Completed: 2-7-58

Contractor: Imperial Oil of Kansas, Inc.  
Wichita 2, Kansas

Casing Record: Set 8-5/8" Surface Pipe at 216' with 150 sacks cement.

Figures indicate bottom of formations:

Surface Clay & Sand	216'		<u>TOPS</u>	
Shale & Sand	1495'	Anhydrite	2215'	( / 316 )
Dakota Sand	1700'	Heebner	3783'	( -1252 )
Shale & Red Bed	2115'	Toronto	3802'	( -1271 )
Shale & Shells	2215'	Lansing	3817'	( -1286 )
Anhydrite (hard)	2260'	Mississippi	4362'	( -1831 )
Shale & Shells	2460'	Viola	4488'	( -1957 )
Shale & Lime	3760'	Arbuckle	4551'	( -2020 )
Lime	4368'	Rotary Total Depth	4600'	( -2069 )
Lime & Chert	4463'			
Lime	4600'			
Total Depth	4600'			

We hereby certify this to be a correct and accurate log of the above described well as shown on the daily drilling reports.

IMPERIAL OIL OF KANSAS, INC.

By: Stanley J. Bourne  
Vice-President



Subscribed and sworn to before me this 21st day of February, 1958.

My Commission Expires:

December 19, 1960

RECEIVED  
STATE CORPORATION COMMISSION

Louella M. Duncan  
Notary Public

FEB 24 1958

CONSERVATION DIVISION  
Wichita, Kansas

2-24-58

PLUGGING		
FILE	SEC. 4 T. 9 R. 25W	
BOOK	PAGE 81	LINE 34